


Section 32 Township 13 Range 14 W

Well No. # 1 Boxberger

Company Kim Oil Co.

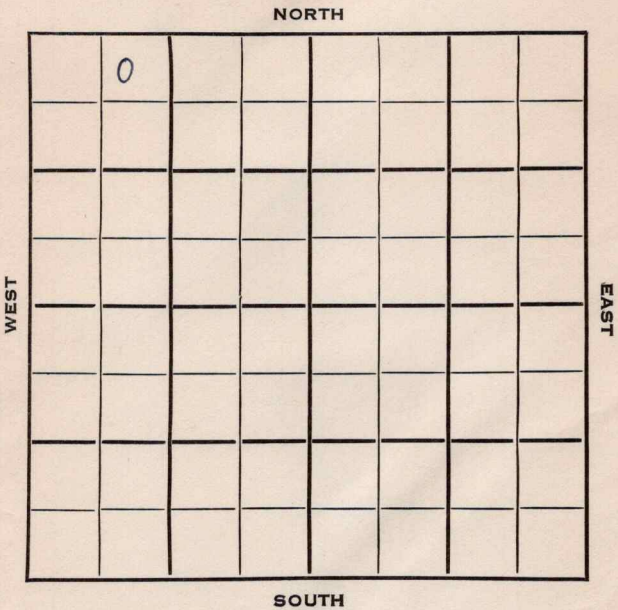

Russell

KANSAS

SEC.	TWP.	R.
32	13	14 W ✓

WELL NO.

1 Boxberger

FARM

COMPANY

Kim Oil Co.

CONTRACTOR

Sidey

Hall-Gurney Pool

330 Ft. from N. Line

Ft. from S. Line

Ft. from E. Line

820 Ft. from W. Line

NORTH

	0					

WEST

EAST

SOUTH

NE NW NW

CSO Farmout

	ELEVATION	REPORT
1954	1876'	

2/3	Spud 1-23-54 8" @ 204 Drlg. 3190'
2/10	Spud 1-23-54 Oil well TD 3317 8" @ 204 Heeb 2991 Lans 3041 Arb. 3311 TD 3313 5" @ 3313 DD 3316 FU 300' oil 14 hr. DD 3317 FU 1100' oil 16 hr. Comp. 25 BOPD

COMPLETED

County **Russell** State **Kansas**
 Sec. **32** (Blk.) **13** (Sur.) **14W** Map No.
 (Twp.) (Rge.)
 Operator **Kim Oil Co.**

Well No. **1** Farm **Boxberger**
 Elev. **1876** Location **NE NW NW**

o					

FIRST REPORT

330 Ft. From **N** Line **NW**
820 Ft. From **W** Line Quarter

1st. Report **FEB 3 1954**

Completion

Remarks **CSO farmout**
Sidey - Contr.

Spudding Date **1-23-54**

Drlg. Data **Hall-Gurney Pool**
8" @ 204 drlg. 3190

County Russell State KansasSec. 32 (Blk.
Twp.) 13 (Sur.
Rge.) 14W Map No.Operator Kim Oil Co.Well No. 1 Farm BoxbergerElev. 1876 Location NE NW NW

0							

330 Ft. From N Line NW820 Ft. From W Line Quarter

1st. Report

Completion FEB 10 1954Remarks Hall-Gurney PoolSidey - Contr.Spudding Date 1-23-54Drig. Data Oil well TD 33178" @ 204 Heeb. 2991 Lans. 3041Arb. 3311 TD 3313 5" @ 3313 DD 3316FU 300' oil 14 hr. DD 3317FU 1100' oil 16 hr. Comp. 25 bopd

J. G. McGEHEE