

Ellis

KANSAS

SEC.	TWP.	R.
34	14	18W

WELL NO.

#1 Engel

FARM

COMPANY

Colorado Oil & Gas

CONTRACTOR

Glenn Peel


WILDCAT

Ft. from N. Line

Ft. from S. Line

Ft. from E. Line

Ft. from W. Line

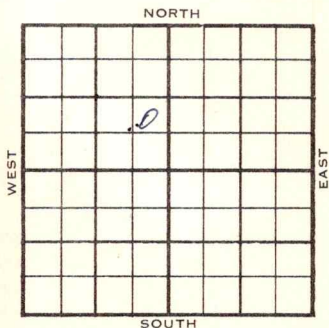

NE SE NW

1956

ELEVATION

2050'

REPORT

4-18

Comm. 4-16-56
8" @ 224 w/175
WOC

6-6

DST 3364'-3420' op 1 hr. rec. 1500' fre
oil, no/wtr., BHP 1190/30"
DST 3595-3625 op 1 hr. rec. 1800' oil
/ 240' O&GCM, FP 170-760, BHP 1030/30"
DST 3428-70 op 1 hr. rec. 15' mud,
BHP 0/20"
DST 3488-3540 op 1 hr. rec. 10' mud,
BHP 400/20".
DST 3595-2625
5 1/2" @ 3624 w/125
CO 3620, 16/ 3612-16
S/ av. 3.3 boph, no/wtr., 10 hrs.
S/ 17 boph, no/wtr., 6 hrs.
Grav. 32.7
P/ 72 BO / 3/10 of 1% Wtr., 4 hrs.
IPP/ 596 BOPD, No/wtr., 34°
H. 3270', L. 3318', BKC 3553',
A. 3613'- 3611'.
TD 3625'

COMPLETED

County Ellis Elev. _____
 Sec. 34 Twp. 14 Rge. 18W
 Company Colorado Oil & Gas
 Farm Name Engel No. 1

TOPS	DEPTH	LOG	DATUM
Anh.			
Tp.			
H.			
Tr.			
Dg.			
Bl.			
L.			
K.C.			
B.K.C.			
Ce.			
C.			
M.			
M.			
K.			
Mz.			
Mq.			
V.			
S.			
S.			
A.			
R.			
PE.			
G.			
T.D.			

Loc. in Sec. _____

NE SE NW

Geol. _____

Contr. _____

Glenn Peel

Pool _____

Wildcat

FIRST REPORT	
0	
APR 18 1956	

Date Comm. 4-16-56
8" @ 224/175 WOC

APR 18 1956
 R. G. a

Co.

Lse.

No.

Sec.

T.

R.

County ELLIS Elev. 2050
 Sec. 34 Twp. 14 Rge. 18W
 Company Colorado Oil & Gas
 Farm Name Engel No. 1

TOPS	DEPTH	LOG	DATUM	Loc. in Sec.
Anb.				NE SE NW
Tr.				
H.	3270			
Tr.				
Dg.				
Bl.				
L.	3318			Geol.
M.C.				Contr.
B.K.C.	3553			Glenn Pool
Ce.				
C.				Pool
M.				Wildcat
M.				
K.				
Mz.				
Mq.				
V.				
S.				
S.				
A.	3613	3611		
R.				
PE.				
G.				
T.D.	3625			

Date Comm. 1-1-56 JUN 6 1956

84 024/175 WDS APR 25 '56 DST 3364

-3420 1hr rec 1500' Free
oil no/w BHP 1190/30" MAY 2 '56
DST 3595-3625 1hr rec 1800'
oil + 240' O&GCM FP 170-760
BHP 1030/30" DST 3428-70
1hr rec 15' Md BHP 0/20"
DST 3488-3540 1hr rec 10' Md
BHP 400/20" DST 3595-3625

34-14-18W
FORM 513-1 SURRAY

Cabo. O.E.G. Engel #1

5 1/2 @ 3624/125 MAY 9 '56 Co 3620

16/3612-16 \$ 8K. 3.3 Boph

no/w 10 hrs 12 \$ 17 Boph

no/w 6 hrs grav 32.7°

MAY 16 '56 P. 72 BO + 3/10 of 100 W

4 hrs

MAY 23 '56

MAY 29 '56

JUN 6 '56

1 PP 596 BOPD NW 34°

ArB

Ellis

KANSAS


18W

SECTION 34 TOWNSHIP 14 RANGE 18W

WELL NO. #1 Engle

COMPANY Colorado Oil & Gas

NORTH

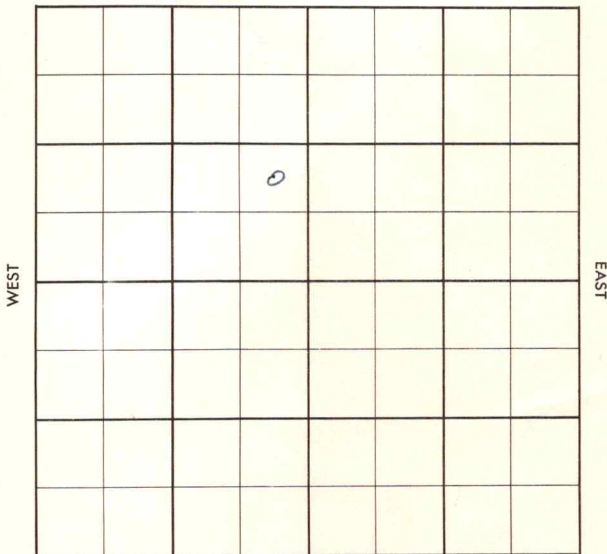

SOUTH