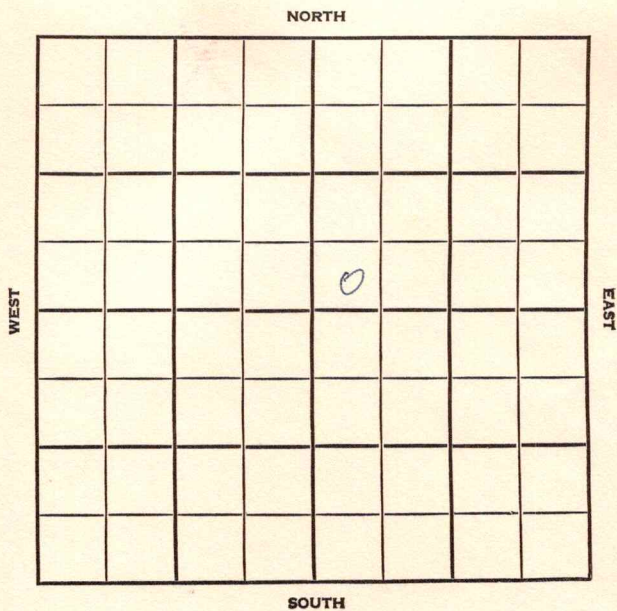


Section 34 Township 14 Range 18WWell No. #2 Engel "A"Company Colorado Oil & Gas

Ellis

KANSAS

SEC.	TWP.	R.
34	14	18W

WELL NO. #2 Engel "A" FARM

COMPANY Colorado Oil & Gas

CONTRACTOR


Engel

_____ FT. FROM N. LINE

_____ FT. FROM S. LINE

_____ FT. FROM E. LINE

_____ FT. FROM W. LINE

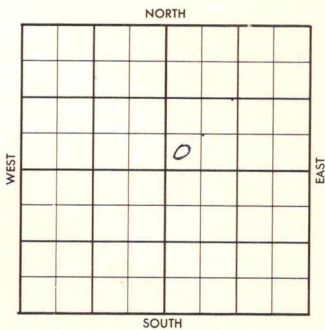

SW SW NE

1956	ELEVATION	REPORT
------	-----------	--------

7-11 Cellar & pits

COMPLETED

County Ellis Elev. _____
 Sec. 34 Twp. 14 Rgs. 18W
 Company Colorado Oil & Gas
 Farm Name Engel "A" No. 2

TOPS	DEPTH	LOG	DATUM	Loc. in Sec.
Anh.				SW SW NE
Tp.				
H.				
Tr.				
Dg.				
B.L.				
L.				Geol.
K.C.				
B.K.C.				Contr.
Ce.				
C.				
M.				
M.				Pool
K.				Engel
Mz.				
Me.				
V.				
S.				FIRST REPORT
S.				O
A.				
R.				
Pf.				
G.				
J.P.				JUL 11 '66

County Ellis Elev. 2048
 Sec. 34 Twp. 11 Rge. 18W
 Company Colorado Oil & Gas
 Farm Name Engel "A" No. 2

TOPS	DEPTH	LOG	DATUM	Loc. in Sec.
Anb.				SW SW NE
Tp.				
H.	3278			
Tr.				
Dg.				
B.L.				
L.	3322			Geol.
K.C.				Contr.
B.K.C.				
Ce.				
C. <u>sd</u>		3620		
M.				<u>New Pay</u>
M.				Pool
K.				<u>Engel</u>
Mz.				
Ma.				
V.				
S.				
S.				
A.	3650			
R.				
Pe.				
G.				
T.D.	3655			

SEP	2 '56
	0
COMPLETE	

Date Comm.

Cellar & pits JUL 18 '56 7-10-56

85/8 258/150 MD 3365 JUL 25 '56

DST 3387-2460 1hr 9/25"

see 900' oil BHP 1080 DST

3372-86 (st PKR) 1hr see 5' Md

680/30" DST 3418-30 1hr see

25' MD 1080/30" DST 3651

-55 1hr see 20' SOC M 1000/30"

DST 3604-32 (st PKR) 1hr see

SEP 5 '56

SEP 12 '56

95' cl. oil + 90' MCO + 288'

HMC0 BHP 805 5 1/2 @ 3652

AUG 1 '56 CO 3655 17 760ph

no/w 4 hrs 1/2 \$.63 BO

+ 9 BWph 4 hrs PB 3640

24/3621-26 \$ 4.38 BO +

3 1/2 BWph 6 hrs T&R

AUG 8 '56

AUG 15 '56

AUG 22 '56

AUG 29 '56

SEP 5 '56

SEP 12 '56

Ph P. 60 Bopd

+ 270 wtr.