


Section 32 Township 13 Range 11W

Well No. 2 Boxberger

Company Kim Oil

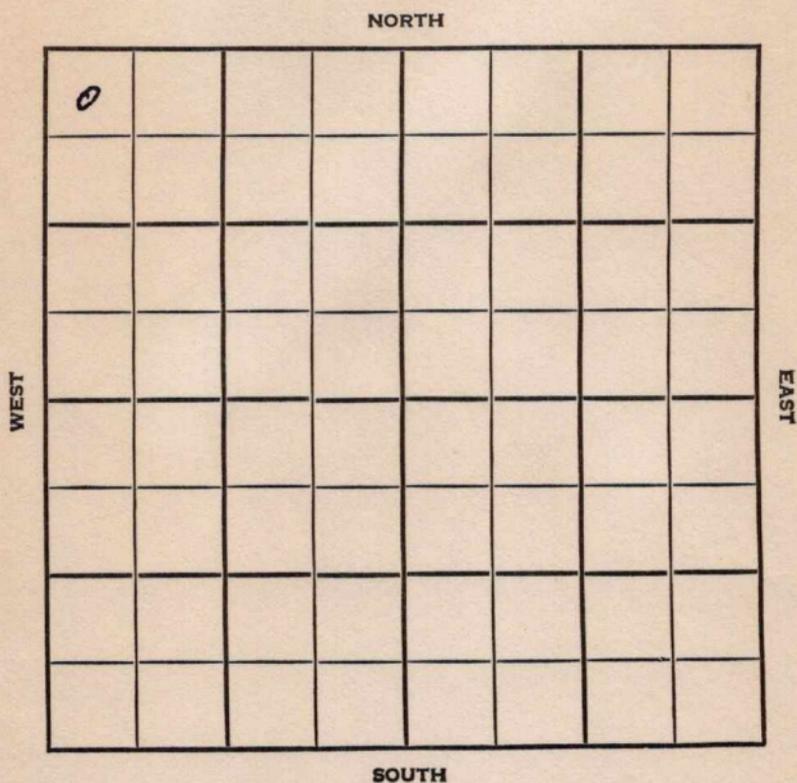

Russell

KANSAS

SEC.	32	TWP.	13	R.	14W
------	----	------	----	----	-----

WELL NO. #2 Boxberger FARM

COMPANY Kim Oil

CONTRACTOR

Atherton Pool

330


Ft. from N. Line

Ft. from S. Line

Ft. from E. Line

330

Ft. from W. Line

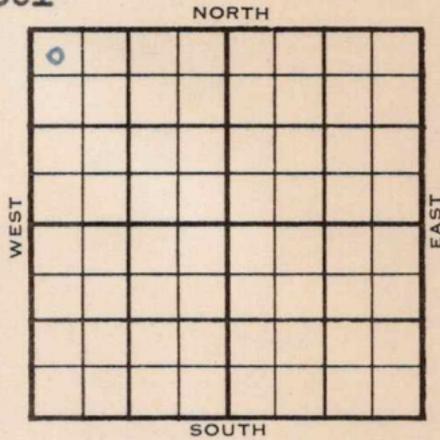

NW NW NW

1954	ELEVATION	REPORT
	1876	

5/26	Location
6/2	"
6/9	"
6/23	"
6/30	"
7/7	8" @ 200'
8-11	Spdg 7-4-54 D&A TD 3330 8" @ 200 Heeb 2994 Lans. 3044 Arb. 3325 TD 3327 5" @ 3326 D D 3330 S/ 2 1/2 boph 10 bw S/ 2 1/2 bo 131 bw 14 hr. D&A

ABANDONED

County Russell State Kansas

Sec. 32 (Blk. 13 (Sur. 14W (Twp.) 13 (Rge.) 14W Map No.

Operator Kim Oil

Well No. 2 Farm Boxberger

Elev. _____ Location NW NW NW

o							

330 Ft. From N Line NW

330 Ft. From W Line Quarter

1st. Report MAY 26 1954

Completion _____

Remarks _____

Spudding Date _____

Drlg. Data Atherton Pool

Location

J. G. McGEHEE

County Russell State Kansas

Sec. 32 (Blk. 13 (Sur. Rge.) 14W Map No.

Operator Kim Oil

Well No. 2 Farm Boxberger

Elev. 1876 Location NW NW NW

o					

330 Ft. From N Line NW

330 Ft. From W Line Quarter

Ist. Report

Completion AUG 11 1954

Remarks Atherton Pool

Mast Drlg. - Contr.

Spudding Date 7-4-54

Drlg. Data D & A TD 3330

8" @ 200 Heeb. 2994 Lans. 3044

Arb. 3325 TD 3327 5" @ 3326

DD 3330 S/ 2 1/2 boph 10 bw S/ 2 1/2 bo

131 bw 14 hr.

D & A