

KANSAS

Russell


Section 32 Township 13 Range 14W

Well No. 2 Boxberger

Company Eldorado Ref.

Russell

NORTH

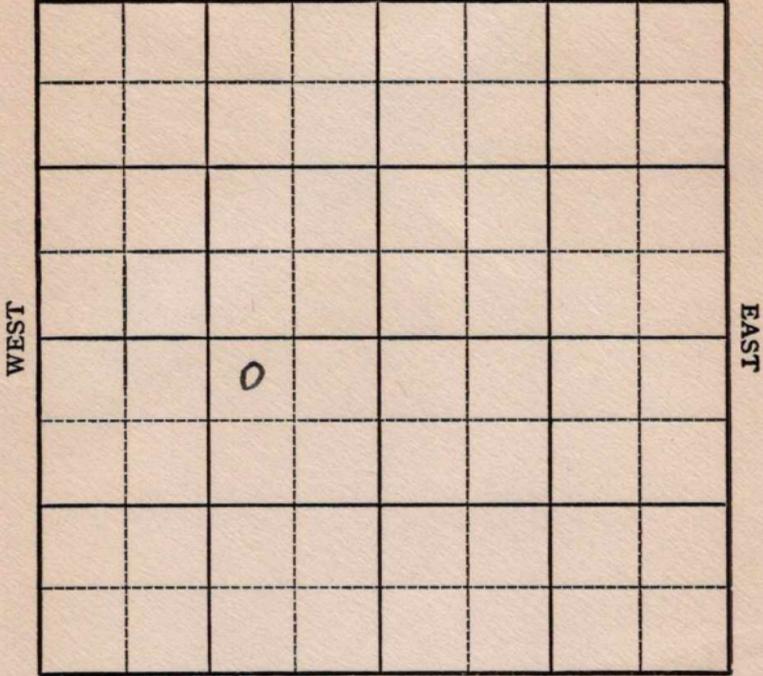

SOUTH

KANSAS

Russell

Sec. 32 Twp. ~~14~~¹³ R. ✓ 14-W
15W


Well No. #2 Boxberger Farm
Eldorado Ref. Company

330' Ft. from N. Line

_____ Ft. from S. Line

990' Ft. from E. Line

_____ Ft. from W. Line

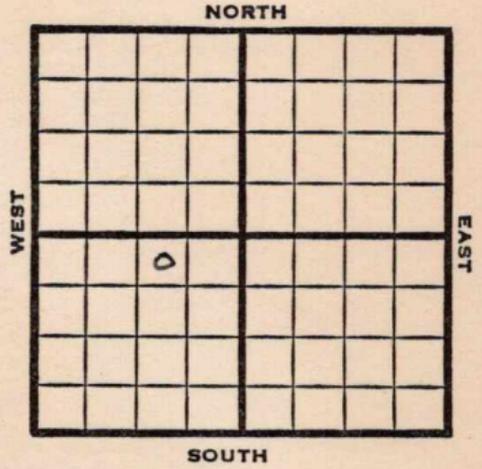

NW NE SW

1949

Elev 1866'

REPORT

3/30

Location

4/6

460 Drlg

4/12

Lansing 3024'

Arb. 3398-3400'

TD 3300'

5"@ 3399'

4/20

TD 3406'

Pump 30 bbls oil a day

4/27

"

5/4

"

5/18

TD 3406'

Arb. 3398'

5"@ 3399'

Pump 40 oil Pot

39° Gr.

Comp

COMPLETED

Kansas

Map No. _____ Sec. 32 Twp. 14 R. 13W

Well No. 2 Boxberger

Eldorado Ref. Company

FIRST REPORT Contractor

NW NE SW


SECTION PLAT

330 Ft. from N. Line

_____ Ft. from S. Line

990 Ft. from E. Line

_____ Ft. from W. Line

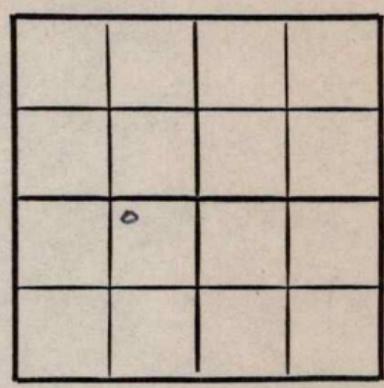

OK
Russell County

RECORD

Location X

Rig up _____

Drilling and Remarks:

Cased _____ in., _____ ft.

Sand _____

Gas _____

Oil _____

Total Depth _____

PRODUCTION

1st 24 hrs. Nat. _____

1st 24 hrs. after shot _____

Gas _____ Cu. Ft.

Dry Hole _____

Abandoned _____

Date

MAR 30 1949 19

S. J. LEWIS Scout

Kansas

Map No. K72 Sec. 32 Twp. 13 R. 14W

Well No. 2 Boxberger

Eldorado Ref. _____ Company _____

COMPLETE

Contractor _____

~~NW NE SW~~

E.I. 1866

SECTION PLAT

330 Ft. from N. Line

_____ Ft. from S. Line

990 Ft. from E. Line

880 Ft. from W. Line

	o		

Russell County

Location _____

Rig up _____

Drilling and Remarks:

*Per 83398.
5" O 83399
Pump 40 oil Per*

39-34

RECORD

Cased _____ in., _____ ft.

Sand _____

Gas _____

Oil _____

Total Depth 3406

PRODUCTION

1st 24 hrs. Nat. _____

1st 24 hrs. after shot _____

Gas _____ Cu. Ft.

Dry Hole _____

Abandoned _____

Date

MAY 11 1949 19

S. J. LEWIS Scout

Kansas

Map No. _____ Sec. 32 Twp. 13 R. 14W

Well No. 2 Boxberger

Eldorado Ref. Company

CORRECTION Contractor

NW NE SW


SECTION PLAT

330 Ft. from N. Line

_____ Ft. from S. Line

990 Ft. from E. Line

_____ Ft. from W. Line

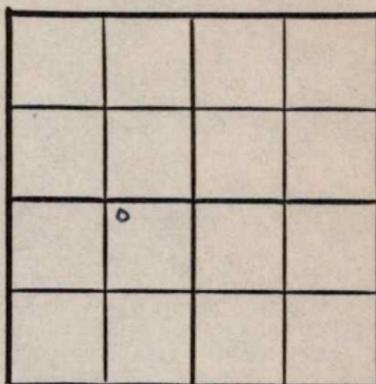

Russell County

Location _____

Rig up _____

Drilling and Remarks:

Reported
32-14-13W

RECORD

Cased _____ in., _____ ft.

Sand _____

Gas _____

Oil _____

Total Depth _____

PRODUCTION

1st 24 hrs. Nat. _____

1st 24 hrs. after shot _____

Gas _____ Cu. Ft.

Dry Hole _____

Abandoned _____

Date

APR 6 1949 19

S. J. LEWIS Scout