


Butler

Map No. *KS* Sec. *12* Twp. *28* R. *5*

Well No. *1-Weaver* Farm
J. E. Goens et al Company

NORTH

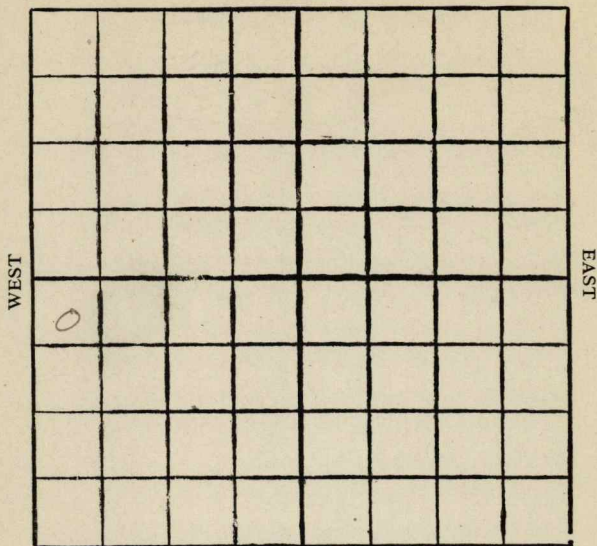

SOUTH

Location

Drilling Remarks

Rig Up

Drilling Remarks

RECORD

Cased in. ft.

Sand

Gas

Oil

Total Depth

PRODUCTION

1st 24 hrs. Nat.

1st 24 hrs. after shot

Gas cu. ft.

Dry Hole


Abandoned

Butler

Map No. 15 Sec. 12 Twp. 28 R. 5Well No. 1-Weaver FarmJ. E. Goens et al Company330 Ft. from N. Line

_____ Ft. from S. Line

_____ Ft. from E. Line

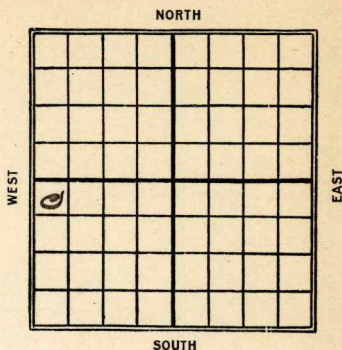330 Ft. from W. Line1926

Date

REPORT

11/17	Drlg 1500'
11/23	Same
12/8	Drlg 2940' 5-bbl show 2731-2736'
12/15	S.D. 3027'
12/22	Same
12/30	5"- 3125
1927	
1/6	Same
1/17	Sand 2731-36 O. + a. 3146

Butler
 11 KANSAS 12 28 5
 Map No. Sec. Twp. R.
 Well No. 1/2 Weaver
 J. E. Soens et al Company

Contractor

FIRST REPORTS

SECTION PLAT

330
 _____ Ft. from N. Line

_____ Ft. from S. Line

_____ Ft. from E. Line

330
 _____ Ft. from W. Line

0			

Location _____

Rig up _____

Drilling and Remarks:

Dlg 1500

RECORD

Cased _____ in., _____ ft.

Sand _____

Gas _____

Oil _____

Total Depth _____

PRODUCTION

1st 24 hrs. Nat. _____

1st 24 hrs. after shot _____

Gas _____ Cu. Ft.

Dry Hole _____

Abandoned _____

Date

NOV 17 1926

CHAS. L. SHERWOOD

192

Scout

Butler

11 KANSAS

Map No.

Sec.

12

Twp.

28

R.

5

Well No.

1 WEAVER

Farm


J. E. Soles et al

Company

NORTH

WEST

EAST

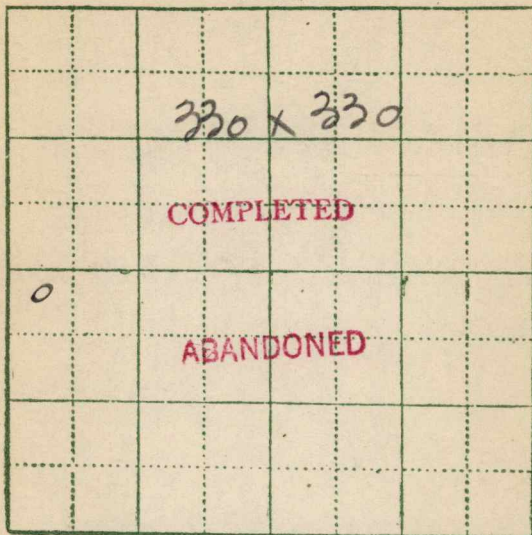

SOUTH

Location _____

Rig up _____

Drilling and Remarks:

5 88 show 2731-36

DO 5

3146

RECORD

Cased _____ in., _____ ft.

Sand _____

Gas _____

Oil _____

Total Depth 3146

PRODUCTION

1st 24 hrs. Nat. _____

1st 24 hrs. after shot _____

Gas _____ Cu. Ft.

Dry Hole ✓

Abandoned ✓

Date JAN 12 1927

CHAS. L. SHERWOOD

192

Scout