


Section 1 Township 14 Range 19WWell No. #1 Kansas "A"Company Skelly

NORTH

WEST

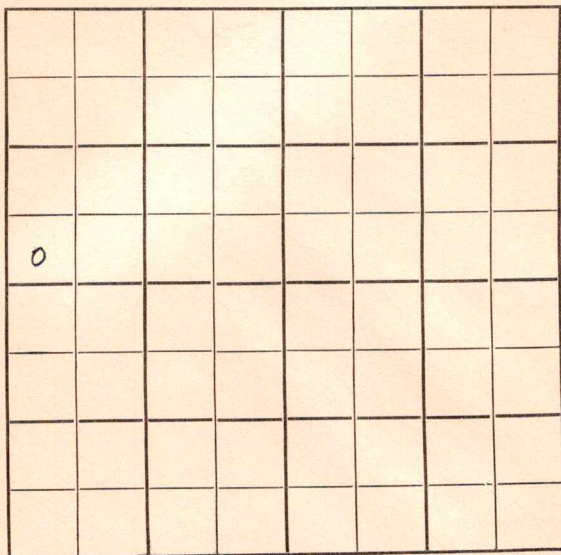

EAST

SOUTH

Ellis

KANSAS

Sec. 1 Twp. 14 R. 19W

#1 Kansas "A"

Well No. _____ Farm _____

Skelly

Wildcat _____ Company _____

_____ Ft. from N. Line

330'


_____ Ft. from S. Line

_____ Ft. from E. Line

330'

_____ Ft. from W. Line

SW NW

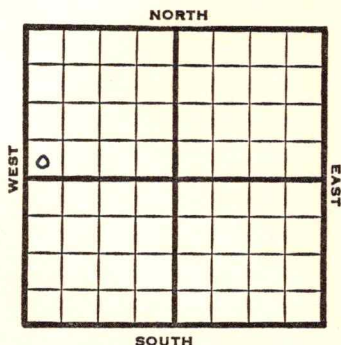

1949 **Elv. 2184'** REPORT

11/23 Location

11/29 "

12/7 RUR

12/14 8" @ 1465'

12/21 Drlg 2500'

12/28 Drlg 3420

1950

1/25 8" @ 1465'

5" @ 3807'

Heeb 3437'

Tor 3459'

Lans 3480'

Show oil 3668-80

DST 3668-80 rec wtr

Cong 3770'

Arb 3806'

P 120 BOPD plus 60 BWPD

TD 3826'

COMPLETED

Map No. _____ Sec. 1 Twp. 14 R. 19W

Well No. 1 Kansas "A"

Skelly Company

Contractor

SW NW

FIRST REPORT
SECTION PLAT


_____ Ft. from N. Line

330 Ft. from S. Line

_____ Ft. from E. Line

330 Ft. from W. Line

Ellis County

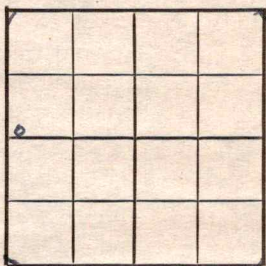

Location X

Rig up _____

Drilling and Remarks:

RECORD

Cased _____ in., _____ ft.

Sand _____

Gas _____

Oil _____

Total Depth _____

PRODUCTION

1st 24 hrs. Nat. _____

1st 24 hrs. after shot _____

Gas _____ Cu. Ft.

Dry Hole _____

Abandoned _____

Date

NOV 23 1949

19

S. J. LEWIS

Scout

Kansas

Wildcat

Map No. _____ Sec. 1 Twp. 14 R. 19WWell No. 1 Kansas "A"

Skelly

Company

Contractor

SW NW

E. 2184

SECTION PLAT

COMPLETE			
o			

____ Ft. from N. Line

330 Ft. from S. Line

____ Ft. from E. Line

330 Ft. from W. Line

Ellis County

RECORD

Location _____

Cased _____ in., _____ ft.

Rig up _____

Sand _____

Drilling and Remarks:

Gas _____

Oil _____

Total Depth 3826

PRODUCTION

1st 24 hrs. Nat. _____

1st 24 hrs. after shot _____

Gas _____ Cu. Ft.

Dry Hole _____

Abandoned _____

Date

JAN 25 1950

J. E. TYRA

19

Scout

Shaw oil 3668-80


D.S.T. 3668-80 rec w/tr.

Cong. 3770

Arb - 3806

P 120 BOPD

plus 60 BWPD

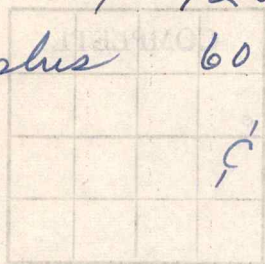

RECORD

Cased

Sand

Gas

Oil

Total

Location

Rig up

Drilling and Remarks

JAN 30 1950

Scout Cards

Long Small Map

Land Wall Map

Tracings

France Map

Pierce Map

Misc.