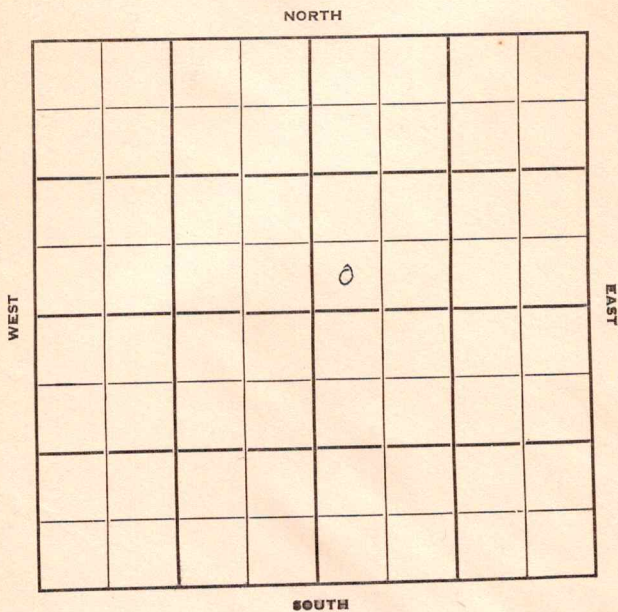


Section 1 Township 14 Range 19-WWell No. #1 State of KansasCompany Francis O & G

Ellis

KANSAS

Sec. 1 Twp. 14 R. 19W

Well No. #1 State of Kansas Farm

Francis Oil & Gas Company

Veeder Supply Contr. Contractor


 Ft. from N. Line

330' Ft. from S. Line

 Ft. from E. Line

330' Ft. from W. Line

SW SW NE

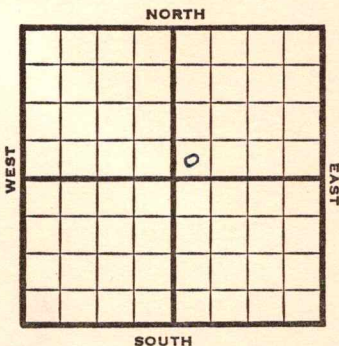

1950

REPORT

9/20

Drlg.
Spud 9-19-50

10/18

Location Abandoned

ABANDONED

County Ellis State Kansas
 Sec. 1 (Blk.) 14 (Sur.) 19W Map No.
 Operator Francis Oil & Gas
 Well No. 1 Farm State of Kansas
 Elev. 2107 Location SW SW NE



330 Ft. From S Line NE
330 Ft. From W Line Quarter

1st. Report

Completion OCT 18 1950

Remarks

Veeder Supply - Contr.

Spudding Date

Drlg. Data

Location abd.

J. E. TYRA