


Ellis

KANSAS

DX 78-1

Section 2 Township 14 Range 19W
Well No. #1 Jacobs
Company Frontier Oil

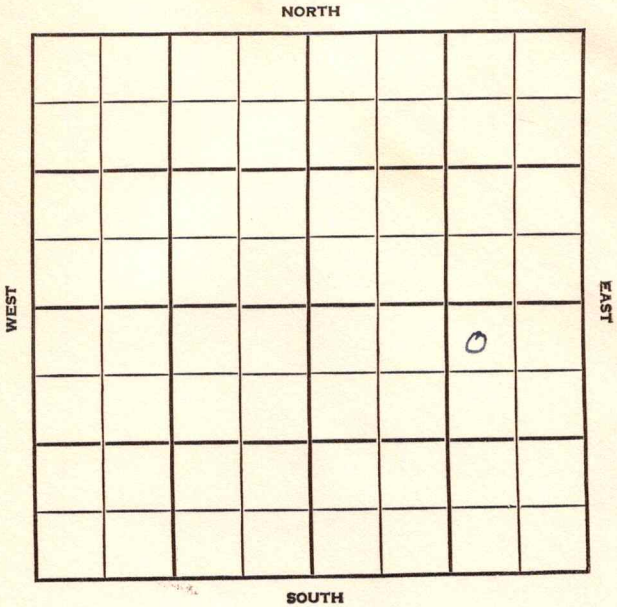

Ellis

KANSAS

SEC.	TWP.	R.
2	14	19W

WELL NO.

#1 Jacobs.

FARM

COMPANY

Frontier Oil

CONTRACTOR


Schafer.

330 Ft. from N. Line

Ft. from S. Line

990 Ft. from E. Line

Ft. from W. Line

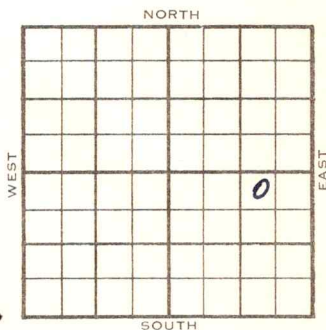

NW NE SE

Mid-States F/0

	ELEVATION	REPORT
1955	2178'	

4/6

M I R

4/20

Spud 4-6-55

D & A

TD 3886'

8" @ 160'

Heeb. 3459', Tor. 3483' Lans. 3505'

B KC 3779', Cong. 3798' Arb. 3869'

TD 3886'

D & A

ABANDONED

County Ellis State KansasSec. 2 (Blk.) 14 (Sur.) 19W Map No.Operator Frontier OilWell No. 1 Farm JacobsElev. Location NW NE SE330 Ft. From N Line SE990 Ft. From E Line Quarter1st. Report APR 6 1955

Completion


Remarks Mid-States farmoutSchafer - Contr.

Spudding Date

Drlg. Data

M I R

FABEN GILSTRAP

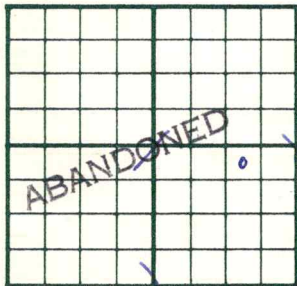County Ellis State KansasSec. 2 (Blk.) 14 (Sur.) 19W Map No.Operator Frontier OilWell No. 1 Farm JacobsElev. 2178 Location NW NE SE330 Ft. From N Line SE990 Ft. From E Line Quarter

1st. Report

Completion APR 20 1955

Remarks

Schafer - Contr.Spudding Date 4-6-55Drlg. Data D & A TD 38868" @ 160 Heeb. 3459 Tor. 3483Lans. 3505 B KC 3779 Cong. 3798Arb. 3869 TD 3886D & A

FABEN GILSTRAP