


Section 11 Township 13 Range 12W

Well No. 1 Sweisgood

Company Champlin Ref.

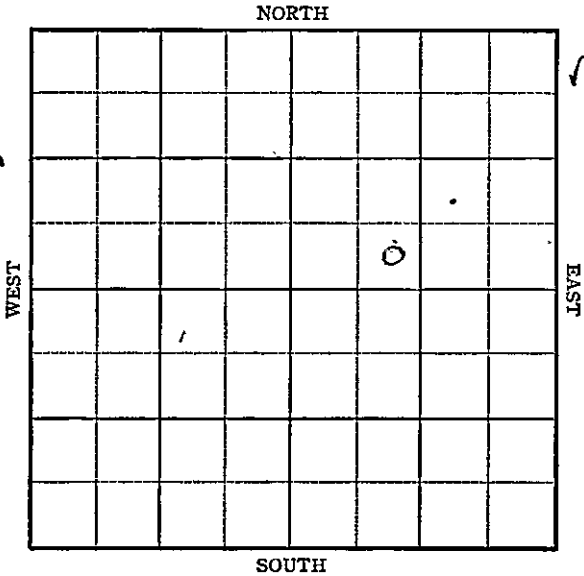

KANSAS

Wallace

Sec. 11 15 Twp. 13W R. 42W

Well No. 1 Sweisgood Farm

Champlin Ref. Company

Wildcat

Ft. from N. Line


330

Ft. from S. Line

Ft. from E. Line

990

Ft. from W. Line

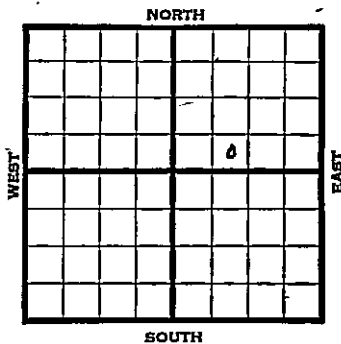

SE SW NE Elev. 3708

1945

REPORT

- 6/20 15" 107'
- 3230
- 6/28 Drlg. 4200'
- 7/3 8" @ 3800 WOO
- TD 4200
- 7/11 " " " "
- 7/19 Drlg. 4660'
- 7/26 Fsg. 5176
- 8/1 " "
- 8/8 Drlg. 5400
- 8/15 Arb. 5490
- TD 5541' SD
- 8/22 Holding for tops
- 8/29 Niobrā 430
- Ft Hays 1200
- Codell 1245
- Dakota 1620
- Lakota 1950
- Norrison 2030
- TD 5541
- Blaine 2340
- Ft. Riley 3420
- Flo 3520
- Wreford 3620
- Tarkio 3972
- Topoka 4123
- Lans 4433
- Miss. 5118
- Arb. 5490
- TD 5541'

ABANDONED


Kansas Pool Name WildcatMap No. no map Sec. 11 Twp. 13 R. 42WWell No. 1 Sweisgood

Champlin Ref. _____ Company _____

FIRST REPORT

Contractor _____

SE SW NE

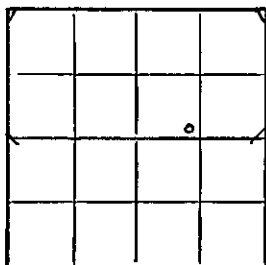SECTION PLAT

_____ Ft. from N. Line

330 Ft. from S. Line

_____ Ft. from E. Line

990 Ft. from W. LineWallace County**RECORD**

Location _____

Cased _____ in., _____ ft.

Rig up _____

Sand _____

Drilling and Remarks:

15"-107

Gas _____

3230

Oil _____

Total Depth _____

PRODUCTION

1st 24 hrs. Nat. _____

1st 24 hrs. after shot _____

Gas _____ Cu. Ft.

Dry Hole _____

Abandoned _____

Date

JUN 20 1945 '19S. J. LEWIS

Scout

KANSAS Kansas Pool Name WildcatMap No. 227 Sec. 11 Twp. 13 R. 42WWell No. 1 Sweisgood

Champlin Ref. _____ Company _____

ABANDONED _____ Contractor _____


SE SW NE

E 13705
SECTION PLAT

_____ Ft. from N. Line

330 Ft. from S. Line

_____ Ft. from E. Line

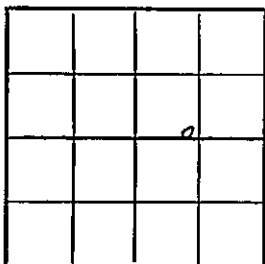990 Ft. from W. Line

Wallace County

Location _____

Rig up _____

Drilling and Remarks:

Nix 430
Ft. Hays 1200
Cochell 1245
Lebota 1620
Lebota 1950
Mossburn 2030

RECORD

Cased _____ in., _____ ft.

Sand _____

Gas _____

Oil _____

Total Depth 2541

PRODUCTION

1st 24 hrs. Nat. _____

1st 24 hrs. after shot _____

Gas _____ Cu. Ft.

Dry Hole _____

Abandoned _____

Date

AUG 29 1945

S. J. LEWIS Scout