


Section 14 Township 28 Range 5-E

Well No. #10 Crowley

Company Nadel & Gussman

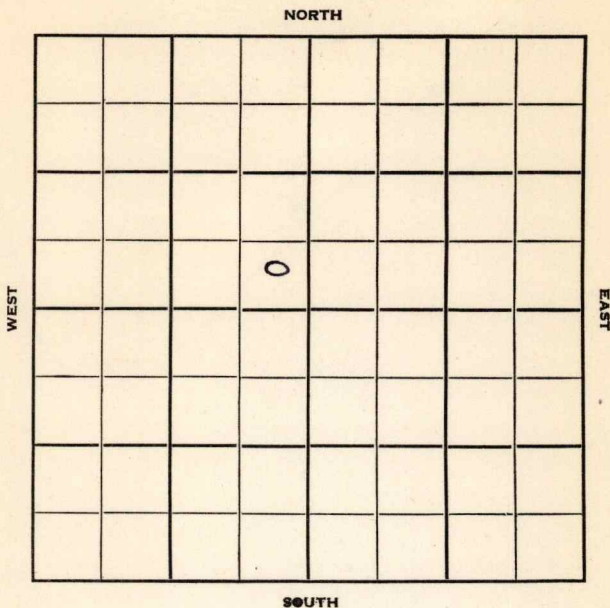

Butler

KANSAS

Sec. 14 Twp. 28 R. 5E ✓

Well No. #10 Crowley Farm

Nadel & Gussman Company

Rex & Morris - Contr. Contractor


 Ft. from N. Line

490' Ft. from S. Line

330' Ft. from E. Line

 Ft. from W. Line

SE SE NW

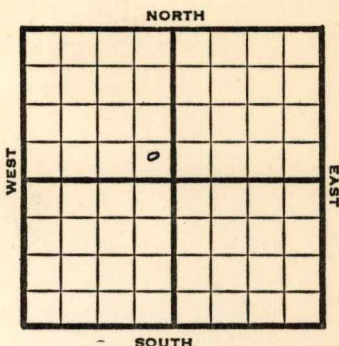

1950

Elev 1266' REPORT

11/15

Spud 11-13-50

12/13

12" @ 830

8" @ 1886

Bart 2678

7" @ 2671


TD 2705

80 qt/2680-2705

Comp 50 bopd

Completed

COMPLETED

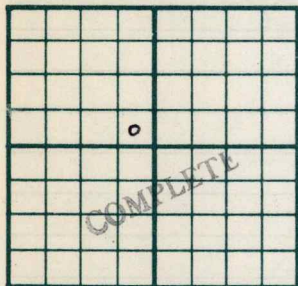County Butler State KansasSec. 14 (Blk.
Twp.) 28 (Sur.
Rge.) 5E Map No.Operator Nadel & GussmanWell No. 10 Farm CrowleyElev. 1266 Location SE SE NW490 Ft. From S Line NW330 Ft. From E Line Quarter1st. ReportCompletion DEC 13 1950RemarksRex & Morris - Contr.Spudding Date 11-13-50Drlg. Data Oil well TD 270512" @ 830 8" @ 1888 Bart. 26787" @ 2671 TD 2705 80 qt/ 2680-2705Comp. 50 bopd

J. E. TYRA