


SECTION 30 TOWNSHIP 30 RANGE 6E

WELL NO. #1 Deterding

COMPANY Beaumont Petroleum

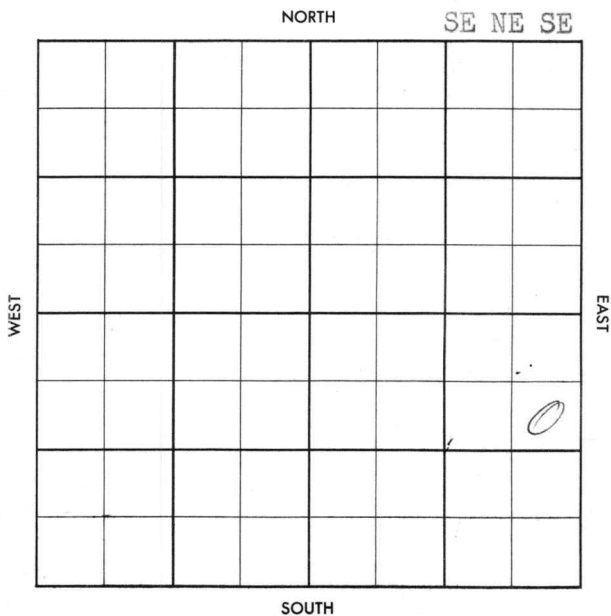

County Cowley Elev. _____
 Sec. 30 Twp. 30 Rge. 6E
 Company Beaumont Petroleum
 Farm Name Deterding No. 1

TOPS	DEPTH	LOG	DATUM	Loc. in Sec.
Anh.				SE NE SE
Sp.				
H.				
Tr.				
Dg.				
Bl.				
L.				Geol. _____
K.C.				Contr. _____
B.K.C.				
Ce.				<u>Co. Tools</u>
C.				
M.				Pool _____
M.				
K.				<u>Eastman</u>
Mz.				
Me.				
V.				
S.				
S.				
A.				
R.				
Pe.				
G.				
T.D.				

FIRST REPORT
 JUN 12 57
 O

ate Comm. _____
 Location _____

~~30~~

Co.

Lse.

No.

Sec.

T.

R.

County Cowley Elev. 1396
 Sec. 30 Twp. 30 Rge. 6E
 Company Beaumont Petroleum
 Farm Name Deterding No. 1

TOPS	DEPTH	LOG	DATUM	Loc. in Sec.
Anh.				SE NE SE
Tr.				
H.				
Tr.				
Dg.				
BL.				
L.				Geol.
K.C.	<u>2234</u>			Contr.
B.K.C.	<u>2465</u>			Co. Tools
Ce. <u>Marm</u>	<u>2560</u>			Pool
C. <u>CG</u>	<u>2695</u>			Eastman
M.				
M. <u>Dart/2H</u>	<u>2874</u>			
K. <u>M135</u>	<u>2947</u>			
Mz.				
Mq.				
V.				
S.				
A.				
R.				
PE.				
G.				
TD.	<u>3010</u>			

ABANDONED

JUL 3 '57

Date Comm.

Location JUN 19 '57 MIRT 6-15-57

8 5/8 128/90 XL

DEA [Signature]