

KANSAS


FORM 51 5M 6-46 PETROL

Butler County

Section 14 Township 28 Range 5E

Well No. 3 Crowley "B"

Company Nadel & Gussman

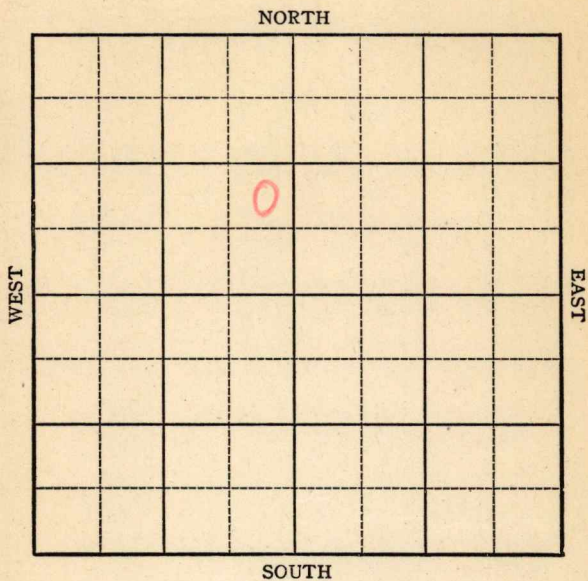

Sec. 14 Twp. 28 R. 5E

Well No. #3 Crowley "B" Farm

Nadel & Gussman Company

Miscellaneous

_____ Ft. from N. Line

990


_____ Ft. from S. Line

330

_____ Ft. from E. Line

_____ Ft. from W. Line

NE SE NW

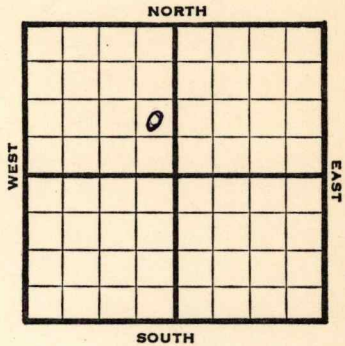

1946 **Elev. 1260'** REPORT

- 8/7 Location
- 8/13 Mach
- 8/20 15" @ 280 Drlg
- 8/27 Drlg 1150'
- 9/5 10" @ 1680'
- 9/10 **Bart 2775'**
2778 Drlg
1 gal oil PH
- 9/17 **Bart 2775'**
6" @ 2776'
TD 2790'
40 qts Acid
Pump 55 POT
GRav. 40

COMPLETED

Pool Name Miscellaneous

Kansas

KANSAS
Map No.

Sec. 14 Twp. 28 R. 5E

Well No. 3 Crowley "B"

Nadel & Gussman Company

FIRST REPORT Contractor

NE SE NW

SECTION PLAT

 Ft. from N. Line

990 Ft. from S. Line

330 Ft. from E. Line

 Ft. from W. Line

	o		

Butler County

Location X

Rig up

Drilling and Remarks:

RECORD

Cased in., ft.

Sand

Gas

Oil

Total Depth

PRODUCTION

1st 24 hrs. Nat.

1st 24 hrs. after shot

Gas Cu. Ft.

Dry Hole

Abandoned

Date

AUG 7 1946 19

S. J. LEWIS Scout

KANSAS

Kansas Pool Name Miscellaneous

Map No. 11 Sec. 14 Twp. 28 R. 5E

Well No. 3 Crowley "B"

Nadel & Gussman Company

COMPLETED

Contractor

NE SE NW

E 1, 1260

SECTION PLAT

	o		

_____ Ft. from N. Line

990 Ft. from S. Line

330 Ft. from E. Line

_____ Ft. from W. Line

Butler County

Location _____

Rig up _____

Drilling and Remarks:

Bar 42775-
6" @ 2776
409 to.
Pump 55 88
40 = 94

RECORD

Cased _____ in., _____ ft.

Sand _____

Gas _____

Oil _____

Total Depth 2790

PRODUCTION

1st 24 hrs. Nat. _____

1st 24 hrs. after shot _____

Gas _____ Cu. Ft.

Dry Hole _____

Abandoned _____

Date

SEP 18 1946 19

S. J. LEWIS Scout