
Ellis KANSAS

DX 78-1

Section 3 Township 14 Range 19W

Well No. 1 Orth

Company Transit Corp

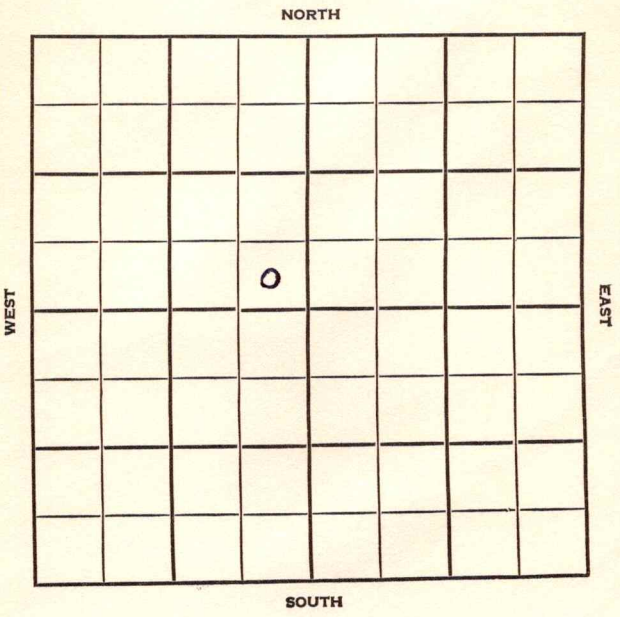

Ellis KANSAS

SEC.	TWP.	R.
3	14	19W

WELL NO.

1 Orth FARM


COMPANY

Transit Corp

CONTRACTOR

Transit- Contr.

Wildcat

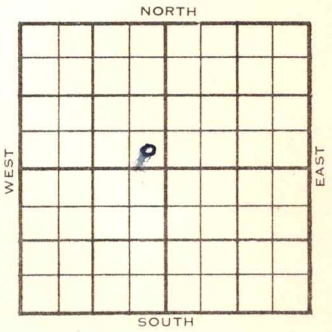

_____ Ft. from N. Line

330 Ft. from S. Line

330 Ft. from E. Line

_____ Ft. from W. Line

SE SE NW Sohio- DHM

ELEVATION 2152'

	REPORT
1954	
6/15	Spdg. 6-8-54 8" @ 179 Anhy 1146 Drlg. 3035
6/23	Spud 6-8-54 - D&A TD 3900' 8" @ 179' Anhy 1146', Heeb 3405', Lans 3453' DST 3620-37', opn 1 hr., rec. 720' SW 1400# Marm. 3737', Cong 3762' DST 3798-3815', opn ½ hrs., rec. 15' SOCM, 540# Arb. 3834' TD 3900' D&A

ABANDONED

DX-78

FORM 275 FOR SALE BY KANSAS BLUE PRINT CO.


County Ellis State Kansas

Sec. 3 (Blk. Twp.) 14 (Sur. Rge.) 19W Map No.

Operator Transit Corp.

Well No. 1 Farm Orth

Elev. 2152 Location SE SE NW

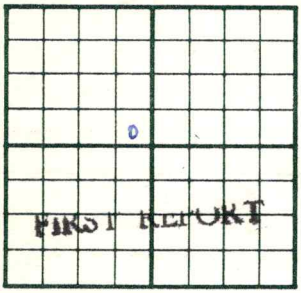

330 Ft. From S Line NW

330 Ft. From E Line Quarter

1st. Report JUN 15 1954

Completion

Remarks Sohio - DHM
Transit - Contr.

Spudding Date 6-8-54

Drlg. Data Wildcat

8" @ 179 Anhy 1146 drlg. 3035

J. G. McGEHEE

FORM 275 FOR SALE BY KANSAS BLUE PRINT CO.

County Ellis State Kansas

Sec. 3 (Blk. Twp.) 14 (Sur. Rge.) 19W Map No.

Operator Transit Corp.

Well No. 1 Farm Orth

Elev. 2152 Location SE SE NW



330 Ft. From S Line NW

330 Ft. From E Line Quarter

1st. Report

Completion JUN 23 1954

Remarks Wildcat

Transit - Contr.

Spudding Date 6-8-54

Drlg. Data D & A TD 3900

8" @ 179 Anhy 1146 Heeb. 3405

Lans. 3453 DST 3620-37 open 1 hr.

Rec. 720' sw 1400# Marm. 3737

Cong. 3762 DST 3798-3815 open ½ hr.

Rec. 15' socm 540# Arb. 3834 TD 3900

D & A

J. G. McGEHEE