


Map No. 15 Sec. 30 Twp. 30 R. 6 ^E

Well No. 1 Biel Farm
Lewis Oil Company

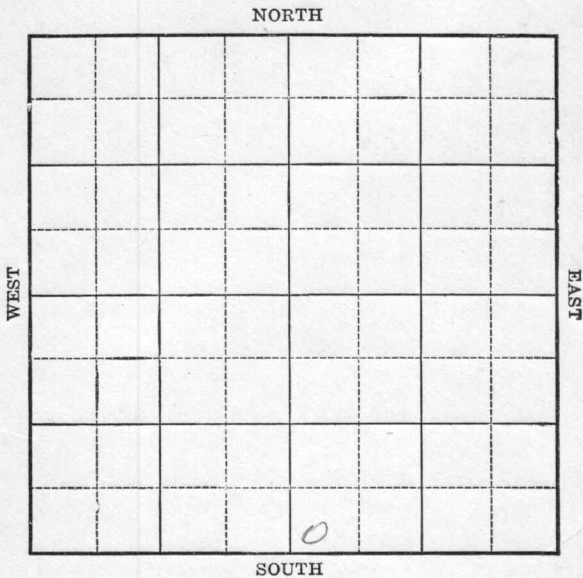

Location _____

Drilling Remarks:

RECORD

Cased _____ in. _____ ft.
Sand _____
Gas _____
Oil _____
Total Depth _____

Rig Up _____

Drilling Remarks:

PRODUCTION

1st 24 hrs. Nat. _____
1st 24 hrs. after shot _____
Gas _____ cu. ft.
Dry Hole _____
Abandoned _____

Map No. 15 Sec. 30 Twp. 30 R. 6^E


Well No. 1 Bice Farm
Lewis oil Company

Ft. from N. Line

200 Ft. from S. Line

Ft. from E. Line

200 Ft. from W. Line

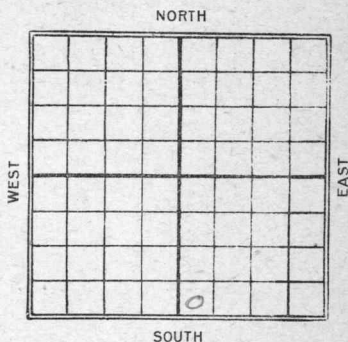

Date _____

REPORT

Date 1924

11/6	Rgn up
------	--------

11/26	Top sand 2869 2 94 Gas
	2869-72 Bottom sand

2889 Top Lime 2918

Qty 2928'

12/11	Top 2869	2869-72 2m Gas
	Btm 2889	Top Lime 2924

S. & A. 2934'

11 **KANSAS** Map No. _____ Sec. 30 Twp. 30 R. 6 E

 Well No. 1 Bice
Lewis Oil Company

_____ Contractor

FIRST REPORT**SECTION PLAT**

_____ Ft. from N. Line

200 Ft. from S. Line

_____ Ft. from E. Line

200 Ft. from W. Line

Location _____

Rig up _____

Drilling and Remarks:

Rig up.
RECORD

Cased _____ in., _____ ft.

Sand _____

Gas _____

Oil _____

Total Depth _____

PRODUCTION

1st 24 hrs. Nat. _____

1st 24 hrs. after shot _____

Gas _____ Cu. Ft.

Dry Hole _____

Abandoned _____

Date

NOV 6 1924

M. A. BENEAR

192

Scout

11 **KANSAS** Map No. _____ Sec. 30 Twp. 30 R. 6

Well No. 1 _____

Lewis Oil _____ Company

_____ Contractor

ABANDONED SECTION PLAT

_____ Ft. from N. Line

200' _____ Ft. from S. Line

_____ Ft. from E. Line

200' _____ Ft. from W. Line

		0	

Location _____

Rig up _____

Drilling and Remarks:

Tap s. 2869
2-mil. gas 2869-72
Bottom sand 2889
Tap Lewis 2924'
10 + 9 2934'

RECORD

Cased _____ in., _____ ft.

Sand _____

Gas _____

Oil _____

Total Depth _____

PRODUCTION

1st 24 hrs. Nat. _____

1st 24 hrs. after shot _____

Gas _____ Cu. Ft.

Dry Hole _____

Abandoned _____

Date **DEC 11 1924**

M. A. BENEAR

_____ 192 _____

_____ Scout