


Section 14 Township 28 Range 5E

Well No. #2 Crowley "B"

Company Nadel & Gussman

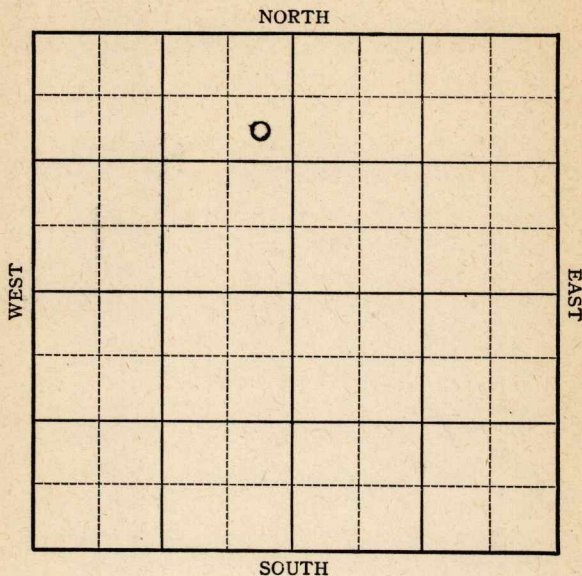

KANSAS

Butler County

Sec. 14 Twp. 28 R. 5E

Well No. #2 Crowley "B" Farm

Nadel & Gussman Company

Miscellaneous

990


Ft. from N. Line

Ft. from S. Line

330

Ft. from E. Line

Ft. from W. Line

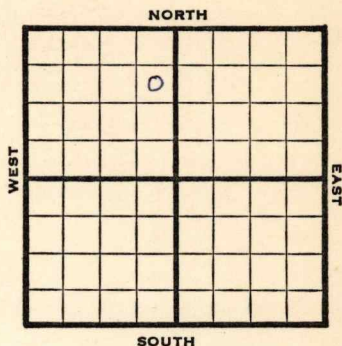

SE NE NW

1946 1267 Elev. REPORT

6/26 Location

7/3 Spud

7/9 15" @ 320
Drlg 800'

7/16 10" @ 1562
Drlg 1695'

7/23 8" @ 2320'
Drlg 2350'

7/30 Lans 1763 KC 2090
Bart 2650
7" @ 2650
TD 2685

500' oil 8 hrs.

8/6 60 qts 2667-83 swb
7 oil PH 16 hrs

8/14 Bart. 2650
7" @ 2650
60 qts.
TD 2685'
Pump 65 Pot.
Grav. 38.4

COMPLETED


KANSAS Kansas Pool Name MiscellaneousMap No. 11 Sec. 14 Twp. 28 R. 5EWell No. 2 Crowley "B"Nadel & Gussman

Company

FIRST REPORT

Contractor

SE NE NW

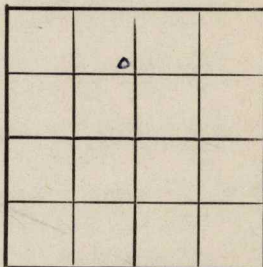SECTION PLAT990 Ft. from N. Line Ft. from S. Line330 Ft. from E. Line Ft. from W. LineButler CountyLocation XRig up

Drilling and Remarks:

RECORDCased in., ft.Sand Gas Oil Total Depth **PRODUCTION**1st 24 hrs. Nat. 1st 24 hrs. after shot Gas Cu. Ft.Dry Hole Abandoned

Date

JUN 26 1946 19S. J. LEWIS

Scout

KANSASKansas Pool Name MiscellaneousMap No. 11 Sec. 14 Twp. 28 R. 5EWell No. 2 Crowley "B"

Nadel & Gussman

Company

COMPLETED

Contractor

SE NE NW

E1, 1267
SECTION PLAT990 Ft. from N. Line

Ft. from S. Line

330 Ft. from E. Line

Ft. from W. Line

	0		

Butler County

Location

Rig up

Drilling and Remarks:

*Bar 2650**7" @ 2650**609 ft.**Pump 65 Bst**354 92***RECORD**

Cased _____ in., _____ ft.

Sand _____

Gas _____

Oil _____

Total Depth *2655***PRODUCTION**

1st 24 hrs. Nat. _____

1st 24 hrs. after shot _____

Gas _____ Cu. Ft.

Dry Hole _____

Abandoned _____

Date

AUG 14 1946

S. J. LEWIS

Scout