FORM 51 5M 11-44 PETROL


KANSAS

Russell

Section 3 Township 15 Range 15W

Well No. #1 Streck

Company Wolf Creek

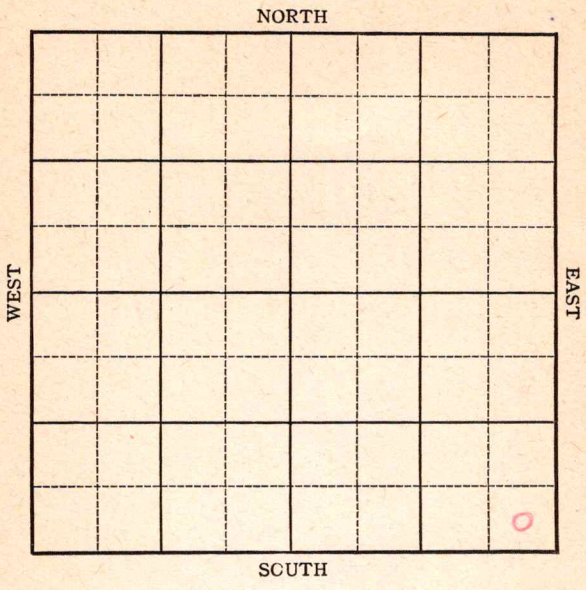

FORM 252-A
5M 9-44 PETROL


KANSAS Russell

Sec. 3 Twp. 15 R. 15W

Well No. #1 Streck Farm

Wolf Creek Company

Donovan

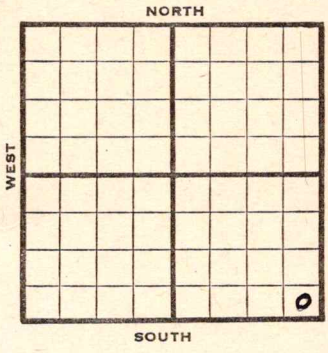

____ Ft. from N. Line

330 Ft. from S. Line

330 Ft. from E. Line

____ Ft. from W. Line

SE/c Elev. 1801

1945	REPORT
2/28	Location
3/7	R U R
3/14	10" @ 605 WOC
3/23	Anhy 860 Drlg. 2287'
3/29	Lans 3031 Drlg. 3061
4/5	Topeka 2745 Arb 3269-76 TD 3276 Sat. 5" @ 3271' RUST
4/12	" " " " "
4/20	TD 3303' SW PB
4/27	PB 3281' SSO
5/3	1000 acid 6 oil plus WPH 5 shots 3211-3216 25 oil a day plus 10 water
5/16	Lans 3031 Arb 3269 5" @ 3271 PB 3150 TD 3308 10 shots 3105-3112 1000 acid. Pump 75 Pot. Grav. 39.0

COMPLETED

FORM 56 200 BKS, 1-44 PETROL

Pool Name Donovan

Map No. 78 Sec. 3 Twp. 15 R. 15W

Well No. 1 Streck


Wolf Creek Company

FIRST REPORT

Contractor

SE/c

SECTION PLAT

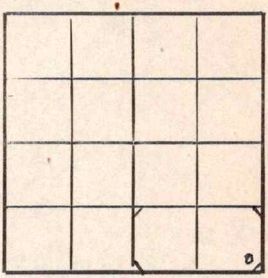

Ft. from N. Line

330 Ft. from S. Line

330 Ft. from E. Line

Ft. from W. Line

Russell

Location X

Rig up

Drilling and Remarks:

RECORD

Cased in., ft.

Sand

Gas

Oil

Total Depth

PRODUCTION

1st 24 hrs. Nat.

1st 24 hrs. after shot

Gas Cu. Ft.

Dry Hole

Abandoned

Date

FEB 28 1945 19 S. J. LEWIS Scout

FORM 26 200 BKS 1-44 PETROL

Kansas Pool Name Donovan

Map No. 73 Sec. 3 Twp. 15 R. 15W

Well No. 1 Streck


Wolf Creek Company

COMPLETED Contractor

SE/c

E 1/2 SW

SECTION PLAT

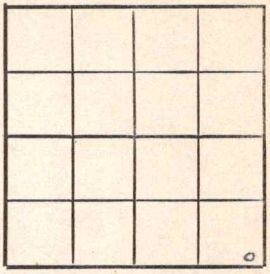

Ft. from N. Line

330 Ft. from S. Line

330 Ft. from E. Line

Ft. from W. Line

Russell County

Location

Rig up

Drilling and Remarks:

Lime 3031
Arb 3268
5' @ 3271
PB 3150
10 shots 3105-12
1000 acid
Pump 70 BT
89° Gr

RECORD

Cased in., ft.

Sand

Gas

Oil

Total Depth 3308

PRODUCTION

1st 24 hrs. Nat.

1st 24 hrs. after shot

Gas Cu. Ft.

Dry Hole

Abandoned

Date

MAY 16 1945 19

S. J. LEWIS Scout