

KANSAS

Russell

FORM 51 IOM 12-46 PETROL

Section 3 Township 15 Range 15-W

Well No. 1 Streck "B"


Company C R A

Donovan Pool

NORTH

WEST

EAST

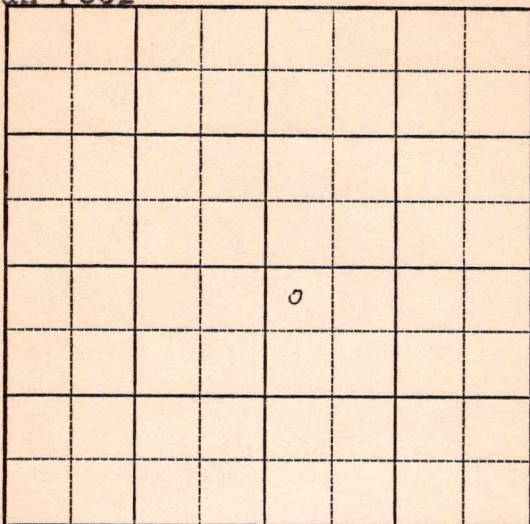

SOUTH

KANSAS Russell

Sec. 3 Twp. 15 R. 15W

Well No. #1 Streak "B" Farm

C. R. A. Company

Donovan


330 Ft. from N. Line

 Ft. from S. Line

 Ft. from E. Line

330 Ft. from W. Line

NW SE

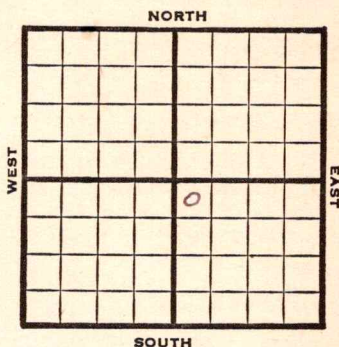

1947

Elev. 1818' REPORT

9/24

Location

10/1

Drlg. 869'

10/8

8" @ 880'
Drlg. 2735'

10/15

Lansing 3005'
Arbuckle 3317'
TD 3324'
5" @ 3320'
RUST

10/22

Plug 3285'
12 shots 3238-42
12 " 3230-34 3000 acid

10/29

Arbuckle 3317'
TD 3324'

ABANDONED

Map No. _____ Sec. 3 Twp. 15 R. 15W

Well No. 1 Streck "B"

C R A Company

FIRST REPORT Contractor

NW SE


SECTION PLAT

330 Ft. from N. Line

_____ Ft. from S. Line

_____ Ft. from E. Line

330 Ft. from W. Line

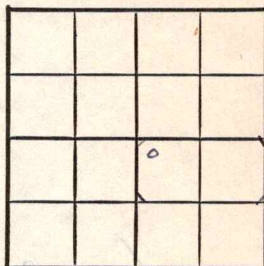

Russell County

Location X

Rig up _____

Drilling and Remarks:

RECORD

Cased _____ in., _____ ft.

Sand _____

Gas _____

Oil _____

Total Depth _____

PRODUCTION

1st 24 hrs. Nat. _____

1st 24 hrs. after shot _____

Gas _____ Cu. Ft.

Dry Hole _____

Abandoned _____

Date

SEP 24 1947 19 S. J. LEWIS Scout

Map No. 73 Sec. 3 Twp. 15 R. 15W

Well No. 1 Streck "B"

C R A

Company

ABANDONED

Contractor

NW SE

P. 11818

SECTION PLAT

330 Ft. from N. Line

_____ Ft. from S. Line

_____ Ft. from E. Line

330 Ft. from W. Line

		0	

Russell County

Location _____

Rig up _____

Drilling and Remarks:

Per 43317

RECORD

Cased _____ in., _____ ft.

Sand _____

Gas _____

Oil _____

Total Depth 3224

PRODUCTION

1st 24 hrs. Nat. _____

1st 24 hrs. after shot _____

Gas _____ Cu. Ft.

Dry Hole _____

Abandoned _____

Date

OCT 29 1947 19

S. J. LEWIS

Scout