

KANSAS

FORM 51 IOM 12-46 PETROL


Butler

Section 14 Township 28 Range 5-E

Well No. 4 Crowley "B"

Company Nadel & Gussman

Miscellaneous NORTH

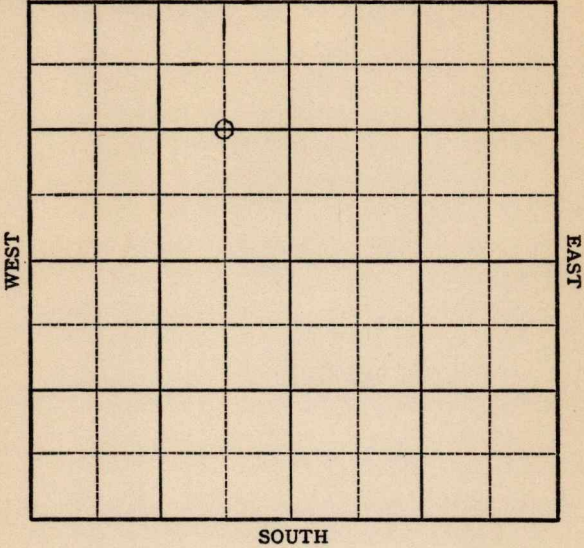

KANSAS

Butler

✓

Sec. 14 Twp. 28 R. 5E

Well No. #4 Crowley "B" Farm


Nadel & Gussman Company
Misc.

1320 Ft. from N. Line

_____ Ft. from S. Line

660 Ft. from E. Line

_____ Ft. from W. Line

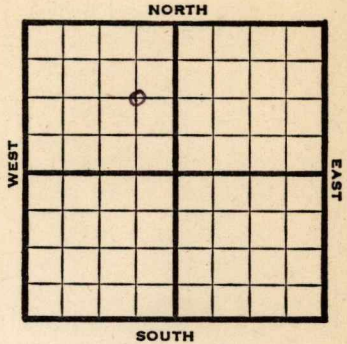

C E $\frac{1}{2}$ NW

1947

Elev. 1262' REPORT

9/17 Spud.

9/24 Drlg. 800'

10/1 12" @ 835'
10" @ 1635'
Drlg. 1655'

10/8 8" @ 1887'
Drlg. 2495'

10/15 **Bart 2672'**
TD 2700'
40 qts 2609-2700
CO

10/22 "

10/29 "

11/5 "

11/12 "

11/19 "

11/25 "

12/3 **Bart 2672'**
6" @ 2660'
40 qts
Pump 240 Pot
Gr. 38'
Total Depth 2700'

COMPLETED

Map No. 11 Sec. 14 Twp. 28 R. 5E

Well No. 4 Crowley "B"

Nadel & Gussman Company

FIRST REPORT Contractor

C E¹/₂ NW


SECTION PLAT

1320 Ft. from N. Line

_____ Ft. from S. Line

660 Ft. from E. Line

_____ Ft. from W. Line

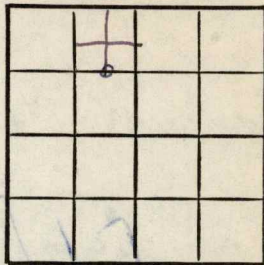

Butler County

Location _____

Rig up _____

Drilling and Remarks:

Spud

RECORD

Cased _____ in., _____ ft.

Sand _____

Gas _____

Oil _____

Total Depth _____

PRODUCTION

1st 24 hrs. Nat. _____

1st 24 hrs. after shot _____

Gas _____ Cu. Ft.

Dry Hole _____

Abandoned _____

Date

SEP 17 1947 19

S. J. LEWIS Scout

