


Section 4 Township 14 Range 19W

Well No. #1 Carl Orth

Company Thunderbird Drlg.

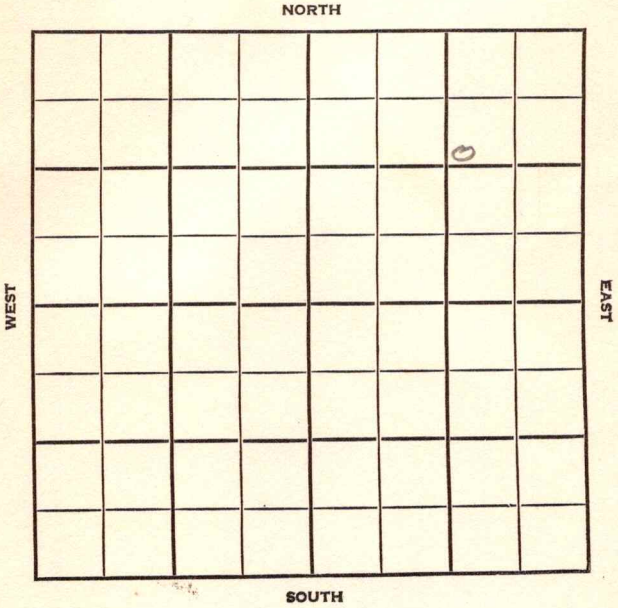

Ellis

KANSAS


SEC.	TWP.	R.
4	14	19 W

WELL NO. # 1 Carl Orth FARM

COMPANY Thunderbird Drlg.

CONTRACTOR Co. tools
E. Irvin

_____ Ft. from N. Line
 _____ Ft. from S. Line
 _____ Ft. from E. Line
 _____ Ft. from W. Line

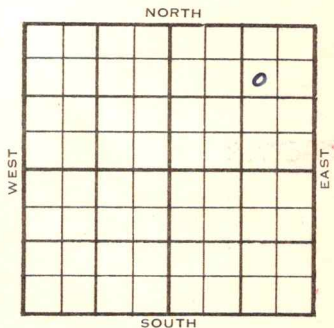

SW NE NE

1955	ELEVATION 2192'	REPORT
------	--------------------	--------

6/15

Spud 5-31-55
 8" @ 191 w/120
 DST 3525-60 open 3/4 hr, rec 8' mud 0#
 DST 3573-97 open 1 hr rec 115' wtry
 mud. 955# D & A
 Anh. 1485', H. 3456', L. 3500',
 Ce 3814', A. 3853'
 TD 3858' D & A

FIRST REPORT

↙
ABANDONED

County Ellis ✓ Elev. 2192
 Sec. 4 Twp. 14 ✓ Rge. 19W
 Company Thunderbird Drlg.
 Farm Name Carl Orth No. 1

TOPS	DEPTH	LOG	DATUM
Anh.	1485		
Tp.			
H.	3456		
Tr.			
Dg.			
B.L.			
L.	3500		
K.C.			
B.K.C.			
Ce.			
C.	3814		
M.			
M.			
K.			
Mz.			
Me.			
V.			
S.			
S.			
A	3853		
R.			
Pe.			
G.			
T.D.	3858		

Loc. in Sec. SW NE NE
 Geol. _____
 Contr. Co. tools
 Pool E. Irvin

JUN 15 1955
 FIRST REPORT
 ABANDONED

Date Comm. 5-31-55
8" @ 191/120 DST 3525-60 open 3/4 hr.
Rec. 8' mud 0# DST 3573-97 open 1 hr.
Rec. 115' wtry mud 955#
D & A

Co.
 Lse.
 No.
 Sec.
 T.
 R.