


DX 78-1

Section 30 Township 30 Range 6E

Well No. #2 Vickery

Company Laura Jane

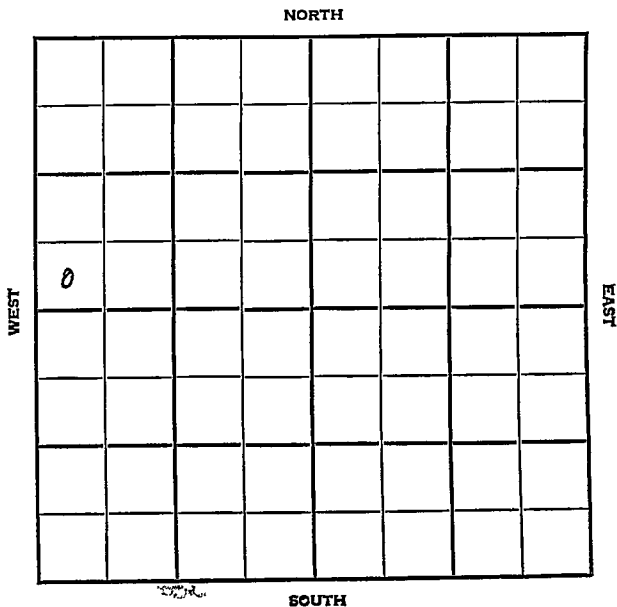

Cowley

KANSAS

SEC.	TWP.	R.
30	30	6E


WELL NO. #2 Vickery FARM

COMPANY Laura Jane

CONTRACTOR

Eastman Pool

_____ Ft. from N. Line
 330 _____ Ft. from S. Line
 _____ Ft. from E. Line
 330 _____ Ft. from W. Line

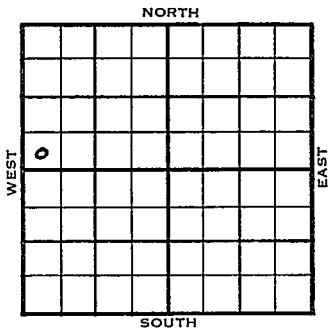

SW SW NW

	ELEVATION	REPORT
1954	1373'	

5/19 Spud 5-10-54
 8" @ 97'
 Drlg 2590'

6/30 Spud 5-10-54 Oil well TD 2932
 8" @ 97' Lans. 2235 Mamm 2622
 Cherokee 2695 Bart. 2882
 TD 2932 5" @ 2932 GO
 16/2895-99 frac. Perf/2889-94
 11/2900-05 2895-99 S/7 BOPH
 dec. to 2 BOPH Comp. 5 BOPD 40 BW

COMPLETED

County Cowley State Kansas

Sec. 30 (Blk. Twp.) 30 (Sur. Rge.) 6E Map No.

Operator Laura Jane

Well No. 2 Farm Vickery

Elev. 1373 Location SW SW NW

330 Ft. From S Line NW

330 Ft. From W Line Quarter

Ist. Report

Completion JUN 30 1954

Remarks Eastman Pool

Spudding Date 5-10-54

Drlg. Data Oil well TD 2932

8" @ 97 Lans. 2235 Marm. 2622

Cherokee 2695 Bart. 2882 TD 2932

5" @ 2932 C0 16/ 2895-99 frac

perf/ 2889-94 11/ 2900-05 2895-99

S/ 7 boph dec. to 2 boph

Comp. 5 bopd 40 bw

J. G. McGEHEE