



Sec. 14 Twp. 28 R. 5E

Well No. #5 Crowley "B" Farm

Nadel & Gussman Company


Misc.

700 Ft. from N. Line

\_\_\_\_\_ Ft. from S. Line

800 Ft. from E. Line

\_\_\_\_\_ Ft. from W. Line

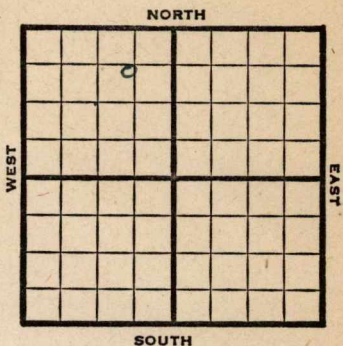

C NE NW

REPORT

1947

**Elev. 1280'**

- 10/15 Location
- 10/22 "
- 10/29 Mach.
- 11/5 Drlg. 425'
- 11/12 15" @ 360'  
13" @ 830'  
Drlg. 1500'
- 11/19 10" @ 1588'  
**Lansing 1765'**  
Drlg. 2140'
- 11/25 8" @ 2315'  
**Bart. 2711'**  
TD 2721'  
7" @ 2704'
- 12/3 TD 2724'  
Swb. 8 bbls. oil PH
- 12/10 "
- 12/17 Pump 100 oil a day.
- 12/30 **Bart. 2711'**  
7" @ 2704'  
Pump 50 Pot  
38.0 Gr.  
TD 2724'

**COMPLETED**

Map No. \_\_\_\_\_ Sec. 14 Twp. 28 R. 5E

Well No. 5 Crowley "B"

Nadel & Gussman Company

FIRST REPORT Contractor

C NE NW

SECTION PLAT

700 Ft. from N. Line

\_\_\_\_\_ Ft. from S. Line

800 Ft. from E. Line

\_\_\_\_\_ Ft. from W. Line

	o		

Butler County

RECORD

Location X

Cased \_\_\_\_\_ in., \_\_\_\_\_ ft.

Rig up \_\_\_\_\_

Sand \_\_\_\_\_

Drilling and Remarks:

Gas \_\_\_\_\_

Oil \_\_\_\_\_

Total Depth \_\_\_\_\_

PRODUCTION

1st 24 hrs. Nat. \_\_\_\_\_

1st 24 hrs. after shot \_\_\_\_\_

Gas \_\_\_\_\_ Cu. Ft.

Dry Hole \_\_\_\_\_

Abandoned \_\_\_\_\_

Date

OCT 15 1947 19

S. J. LEWIS Scout

Map No. 11 Sec. 14 Twp. 28 R. 5E

Well No. 5 Crowley "B"

Nadel & Gussman Company

COMPLETE Contractor

C NE NW

*E. 1, 1250*  
SECTION PLAT

700 Ft. from N. Line

\_\_\_\_\_ Ft. from S. Line

800 Ft. from E. Line

\_\_\_\_\_ Ft. from W. Line

	o		

Butler County

Location \_\_\_\_\_

Rig up \_\_\_\_\_

Drilling and Remarks:

*Bar 2711*

*7" @ 2704*

*Pring 50 Rod*

*0875*

RECORD

Cased \_\_\_\_\_ in., \_\_\_\_\_ ft.

Sand \_\_\_\_\_

Gas \_\_\_\_\_

Oil \_\_\_\_\_

Total Depth 272.4

PRODUCTION

1st 24 hrs. Nat. \_\_\_\_\_

1st 24 hrs. after shot \_\_\_\_\_

Gas \_\_\_\_\_ Cu. Ft.

Dry Hole \_\_\_\_\_

Abandoned \_\_\_\_\_

Date

DEC 30 1947 19

S. J. LEWIS Scout