


Ellis KANSAS

SECTION 1 TOWNSHIP 14S RANGE 17W

WELL NO. #1 Anderson

COMPANY Hinkle Oil Co.

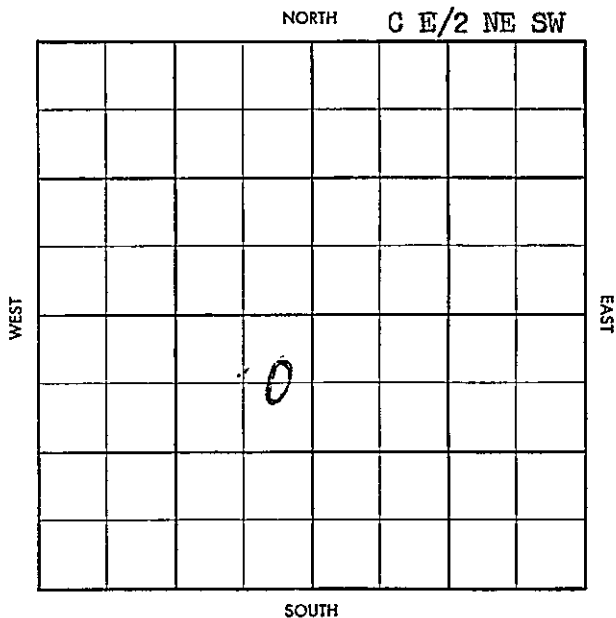


County Elvis Elev. 1924RB
 Sec. 1 Twp. 14 Rge. 17W
 Company Hinkle Oil Co.
 Farm Name Anderson No. 1

TOPS	DEPTH	LOG	DATUM
Anh.			
Tp.			
H.	3155		
Tr.			
Dg.			
B.L.			
L.	3204		
K.C.			
B.K.C.			
Ce.			
C.			
M.			
M.			
K.			
Mz.			
Mq.			
V.			
S.			
S.			
A.			
R.			
Pf.			
G.			
T.D.			

Loc. in Sec. C E/2 NE SW

Geol. Birmingham-
Bartlett
 Pool

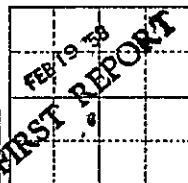

Date Comm. 2/11/58

8" @ 217 w/200, tops. DST 3205-3238 1 1/4 hrs,
110' muddy SW BHP 650/20, Drlg. 3246.

S-513-B

County Ellis Elev. 1924RB 172108
 Sec. 1 Twp. 11N Rge. 17W
 Company Hinkle Oil Co.
 Farm Name Anderson No. 1

TOPS	DEPTH	LOG	DATUM
Anh.			
Tp.			
H.	3155		
Tr.	3175		
Dg.			
B.L.			
L.	3204		
K.C.			
B.K.C.			
Ce.			
C.	3447		
M.			
M.			
K.			
Mz.			
Mq.			
V.			
S.			
S.			
A.	3461		
R.			
Pf.			
G.			
T.D.	3501		

Loc. in Sec. C E/2 NE SW

Geol. _____
 Contr. _____
Birmingham-
Bartlett
 Pool _____

ABANDONED
 FEB 26 '58

Date Comm. 2/11/58
8" @ 217 w/200, tops. DST 3205-3238 1 1/2 hrs,
110' muddy SW BHP 650/20, Drlg. 3246. FEB 26 '58
DST 3249-78 60" 20" N BHP 1306

DBA