


Map No. Kansas Sec. 31 Twp. 30 R. 6Well No. 5 Crouch FarmLewis Oil Company

NORTH

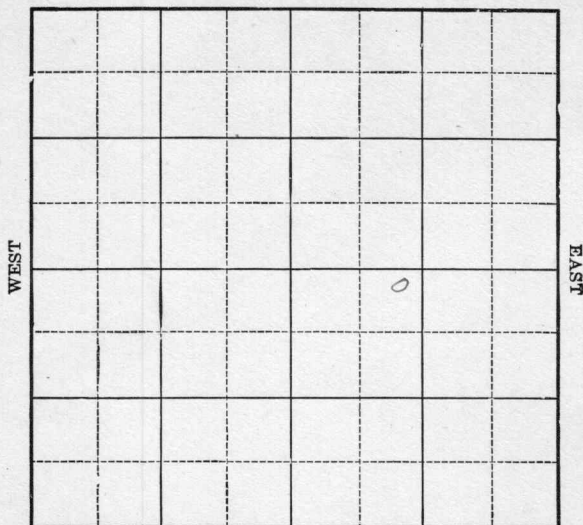

SOUTH

Location _____

Drilling Remarks _____

Rig Up _____

Drilling Remarks _____

RECORD

Cased _____ in. _____ ft.

Sand _____

Gas _____

Oil _____

Total Depth _____

PRODUCTION

1st 24 hrs. Nat. _____

1st. 24 hrs. after shot _____

Gas _____ cu. ft.

Dry Hole _____


Abandoned _____

Map No. Kansas Sec. 31 Twp. 30 R 6Well No. 5 Crouch FarmLewis Oil Company330 Ft. from N. Line

Ft. from S. Line

200 Ft. from E. Line

Ft. from W. Line

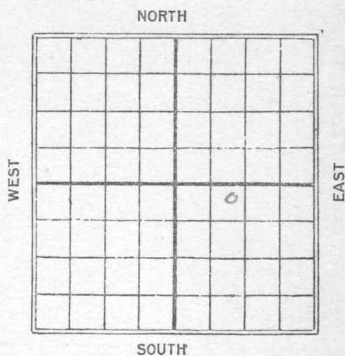

Date

REPORT

19253/1Rig up3/30Abandoned 250

11
 Map No. KANSAS Sec. 31 Twp. 30 R. 6
Well No. 5 CrouchLewis Oil Company

Contractor

FIRST REPORT

330 Ft. from N. Line

Ft. from S. Line

200 Ft. from E. Line

Ft. from W. Line

SECTION PLAT

		0	

Location

Rig up ✓✓

Drilling and Remarks:

RECORD

Cased _____ in., _____ ft.

Sand _____

Gas _____

Oil _____

Total Depth _____

PRODUCTION

1st 24 hrs. Nat. _____

1st 24 hrs. after shot _____

Gas _____ Cu. Ft.

Dry Hole _____

Abandoned _____

Date

3/1 1925

M. A. BENEAR

Scout

11 **KANSAS** Sec. 31 Twp. 30 R. 6
 Map No. _____



_____ Contractor

ABANDONED SECTION PLAT

330 Ft. from N. Line

_____ Ft. from S. Line

200 Ft. from E. Line

_____ Ft. from W. Line

		0	

Location _____

Rig up _____

Drilling and Remarks: _____

RECORD

Cased _____ in., _____ ft.

Sand _____

Gas _____

Oil _____

Total Depth _____

PRODUCTION

1st 24 hrs. Nat. _____

1st 24 hrs. after shot _____

Gas _____ Cu. Ft.

Dry Hole _____

Abandoned 250' _____

Date

3/30 1925

M. A. BENEAR

_____ Scout