

KANSAS


Butler

FORM 51 25M 3-49 PETROL

Section 14 Township 28 Range 5-E

Well No. #9 Cowley "B"

Company Nadel & Gussman

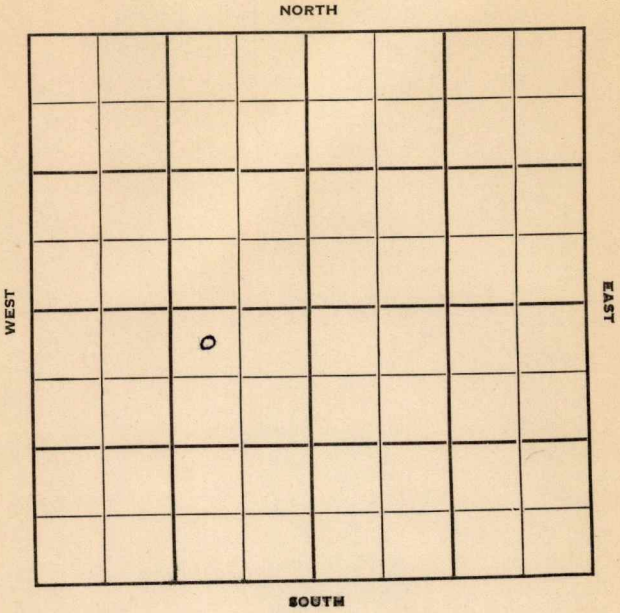

Sec. 14 Twp. 28 R. 5E

Well No. #9 Cowley "B" Farm

Nadel & Gussman Company

Rex & Morris - Contr. Contractor


330' Ft. from N. Line

_____ Ft. from S. Line

990' Ft. from E. Line

_____ Ft. from W. Line

NW NE SW

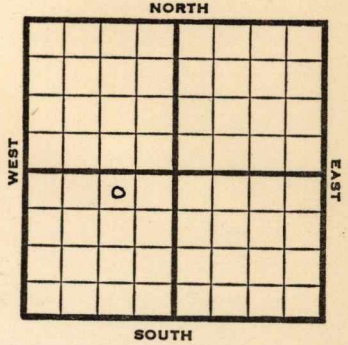

1950

Elev 1262'

REPORT

10/18

Location

11/15

Spud 10-18-50

20" @ 12

Miss 2695-2706 TD

TD 2706'

D&A

ABANDONED

