


Map No. 15 Sec. 31 Twp. 30 R. 6Well No. 2 Elliott FarmLewis Company

NORTH

WEST

EAST

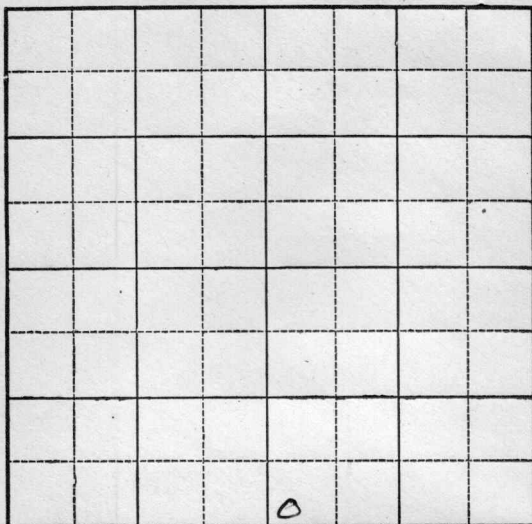

SOUTH

Location _____

Drilling Remarks:

Rig up _____

Drilling Remarks:

RECORD

Cased _____ in. _____ ft.

Sand _____

Gas _____

Oil _____

Total Depth _____

PRODUCTION

1st 24 hrs Nat. _____

1st 24 hrs. after shot _____

Gas _____ cu. ft.

Dry Hole _____

Abandoned _____

Map No. **KANSAS** Sec. 31 Twp. 30 R. 6

Well No. # 2 Elliott

Lewis Company

Contractor

FIRST REPORT

SECTION PLAT

_____ Ft. from N. Line

200 Ft. from S. Line

_____ Ft. from E. Line

200 Ft. from W. Line

Location _____

Rig up ✓✓

Drilling and Remarks:

RECORD

Cased _____ in., _____ ft.

Sand _____

Gas _____

Oil _____

Total Depth _____

PRODUCTION

1st 24 hrs. Nat. _____

1st 24 hrs. after shot _____

Gas _____ Cu. Ft.

Dry Hole _____

Abandoned _____

Date

MAY 22 1924

192

M. A. BENEAR

Scout

K11 **KANSAS** Sec. *31* Twp. *30* R. *6*
 Well No. *2 Elliott*
Lewis oil Company

Contractor

COMPLETED

SECTION PLAT

----- Ft. from N. Line

200 ----- Ft. from S. Line

----- Ft. from E. Line

200 ----- Ft. from W. Line

		0	

Location -----

Rig up -----

Drilling and Remarks:

Depos. 2850-10m Gas

oil 2901 - 2907

20 Hb Nat

RECORD

Cased ----- in., ----- ft.

Sand -----

Gas -----

Oil -----

Total Depth -----

PRODUCTION

1st 24 hrs. Nat. -----

1st 24 hrs. after shot -----

Gas ----- Cu. Ft.

Dry Hole -----

Abandoned -----

Date

OCT 8 1924

192-----

M. A. BENEAR

Scout