

Map No. _____ Sec. 21 Twp. 30 R. 6

Well No. 1 F Elliott Farm
Lewis Oil Company

NORTH

WEST

EAST

SOUTH

Location _____

Drilling Remarks:

Rig Up _____

Drilling Remarks:

RECORD

Cased _____ in. _____ ft.

Sand _____

Gas _____

Oil_____

Total Depth_____

PRODUCTION

1st 24 hrs. Nat. _____

1st 24 hrs. after shot_____

Gas _____ cu. ft.

Dry Hole _____

Abandoned _____

Map No. K Sec. 31 Twp. 30 R. 6


Well No. 1 H Elliott Farm
Lewis Oil Company

_____ Ft. from N. Line

200 Ft. from S. Line

_____ Ft. from E. Line

1120 Ft. from W. Line

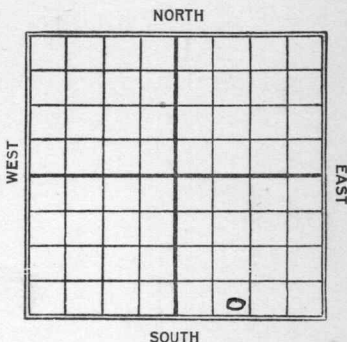

Date	REPORT
1/18	Roy
4/23	2840-68-30 M gas
	at 2868-72-flow
	150 Bbls

Map No. **KANSAS** 11 31 Sec. 30 Twp. 6 R. 6Well No. *1 F E Elliott**Lewis Oil* Company

Contractor

FIRST REPORT**SECTION PLAT**

Ft. from N. Line

200 Ft. from S. Line

Ft. from E. Line

1120 Ft. from W. Line

Location

Rig up

Drilling and Remarks:

*R.O. G.***RECORD**

Cased _____ in., _____ ft.

Sand _____

Gas _____

Oil _____

Total Depth _____

PRODUCTION

1st 24 hrs. Nat. _____

1st 24 hrs. after shot _____

Gas _____ Cu. Ft.

Dry Hole _____

Abandoned _____

Date

JAN 18 1924

M. A. BENEAR

192

Scout

Map No. **KANSAS** 11 Sec. **31** Twp. **30** R. **6**

Well No. **1 Elliott**

Lewis oil Company

Contractor

COMPLETED SECTION PLAT

_____ Ft. from N. Line

200 Ft. from S. Line

_____ Ft. from E. Line

1120 Ft. from W. Line

Location _____

Rig up _____

Drilling and Remarks:

Gas. 2840-68

Oil 2868-72

flow 150 ft

RECORD

Cased _____ in., _____ ft.

Sand _____

Gas _____

Oil **30 m. Gas**

Total Depth _____

PRODUCTION

1st 24 hrs. Nat. _____

1st 24 hrs. after shot _____

Gas _____ Cu. Ft.

Dry Hole _____

Abandoned _____

Date

APR 23 1924

192

M. A. BENEAR

Scout