
Ellis

KANSAS

SECTION 2 TOWNSHIP 14 RANGE 17W

WELL NO. #2 Braun "B"

COMPANY Piper Pet

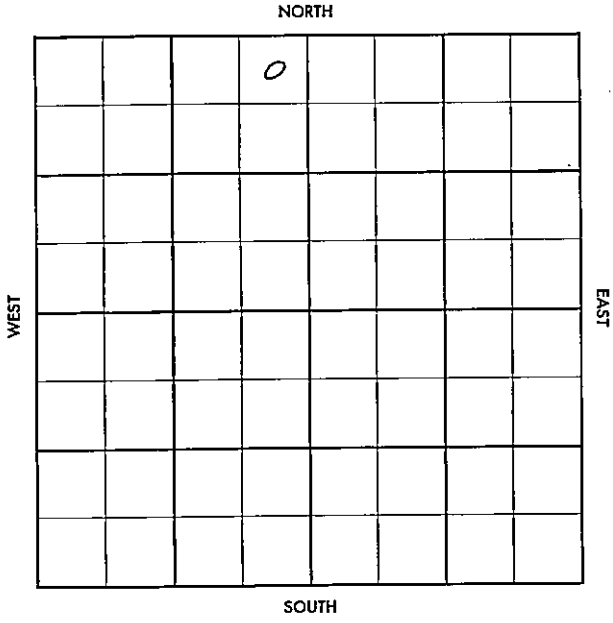

FORM 504-3 SUNRAY

Ellis **KANSAS**

SEC.	TWP.	R.
2	14	17W

WELL NO. #2 Braun "B" FARM

COMPANY Piper Petr.

CONTRACTOR Tom Allan

Toulon


_____ Ft. from N. Line

_____ Ft. from S. Line

_____ Ft. from E. Line

_____ Ft. from W. Line

NE NE NW

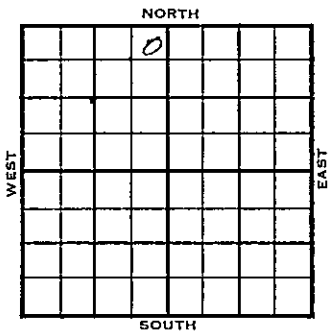

1956 ELEVATION 1947' REPORT

4-18 Comm. 4-13-56
8" @ 900 w/330
WOC

5-23 DST 3218-50 op 1 hr. ~~xxxx~~ 900'gas, rec. 240' vho&gcm, + 180' mdy oil, BHP 480/20".
DST 3254-76 op 1 hr. rec. 285' SW, BHP 440/20".
DST 3284-3353 op 1 hr. rec. 510' SW, BHP 1000/20"
5½" @ 3461 w/150
DD 3469
S/ 15 GOPH, nat.
S/ 3 boph, no/wtr.,
PB 3315- 24/3243-47
Tst. wtr., ~~xx~~
Sqd. 16/ 3243-47
CO 3469
S/ 3 Boph
Est. P/ 30 bopd, no/~~wtr~~.
H. 3170', L. 3216', A. 3460'.
TD 3462'

COMPLETED

DX-78

FORM 513 SUNRAY

County Ellis Elev. Co.

Sec. 2 Twp. 13S Rge. 17W

Company Piper Pet.

Farm Name Braun "B" No. 2

TOPS	DEPTH	LOG	DATUM
Anh.			
Tp.			
H.			
Tr.			
Dg.			
Bl.			
L.			
K.C.			
B.K.C.			
Ce.			
C.			
M.			
M.			
K.			
Mz.			
Mo.			
V.			
S.			
S.			
A			
R.			
Pe.			
G.			
T.D.			

Loc. in Sec. NE NE NW

Geol.

Contr. Tom Allen Lse.

Pool Toulon

FIRST REPORT

APPS

No.

Date Comm. 4-13-56 Sec.

8⅝" @ 900/330 WOC T.

R.

FORM 513 SUNRAY

County Ellis Elev. 1947

Sec. 2 Twp. 11 Rge. 17W

Company Piper Pet.

Farm Name Braum "B" No. 2

TOPS	DEPTH	LOG	DATUM
Anh.			
Tp.			
H.	3170		
Tr.			
Dg.			
Bl.			
L.	3216		
K.C.			
B.K.C.			
Ce.			
C.			
M.			
M.			
K.			
Mz.			
Mo.			
V.			
S.			
S.			
A	3460		
R.			
Pe.			
G.			
T.D.	3462		

Loc. in Sec. NE NE NW

Geol.

Contr. Tom Allan

Pool Toulon

COMPLETE

Date Comm. 4-13-56 MAY 23 1956

8" @ 900/330 PTD APR 25 '56 Ø 3152

MAY. 2 '56 DST 3218-50 1hr 900' 925' rec. 240' VHOCGCM + 180' Mdy oil BHP 480/20 DST 3254-76 1hr rec 285' SW BHP 440/20" DST 3284-3353 1hr rec 510' SW BHP 1000/20" 5½ 3461 1150 DD 3469 Ø 15 BOPH no t.

MAY 9 '56 Nc Ø 3 BOPH no/w PB

2- 14- 17 W

FORM 515-I SUNRAY

3315' 24/3243-47 tst wtr
Sod. 16/3243-47 1/8 tst wtr
Sod. CO 3469 TD & 3 Bopd
MAY 16 '56 PoP MAY 23 '56 est P.
30 Bopd no wtr.