

Butler

KANSAS

SECTION 15 TOWNSHIP 28 RANGE 5 E

WELL NO. #1 Crowley "B"

COMPANY R. H. Suhr

NORTH

			0				
WEST							EAST

SOUTH

Butler

KANSAS

SEC.	TWP.	R.
15	28	5E


WELL NO. #1 Crowley "B" FARM

COMPANY R. H. Suhr

CONTRACTOR White & Ellis

Wildcat

_____ Ft. from N. Line
 _____ Ft. from S. Line
 _____ Ft. from E. Line
 _____ Ft. from W. Line

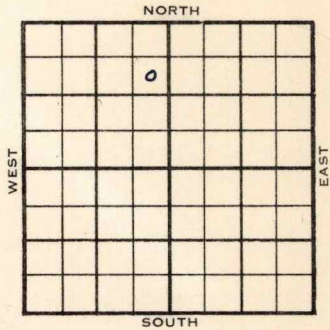

SE NE N/w

	ELEVATION	REPORT
1955	1287'	

11/2 OTD 2790
 KC 2143
 M 2749
 DD 3278

11/9 OTD: 2790
 KC 2143
 M 2749
 A 3191
 TD 3792
 DD 3278
 D & A

ABANDONED

County Butler Elev. _____
 Sec. 15 Twp. 28 Rge. 5E
 Company R. H. Suhr
 Farm Name Crowley "B" No. 1

TOPS	DEPTH	LOG	DATUM	Loc. in Sec.
Anh.				SE NE NW
TP.				
H.				
Tr.				
Dg.				
Bl.				
L.				
K.C.	2143			Geol. _____
B.K.C.				Contr. _____
Ce.				White & Ellis
C.	2749			
M.				Pool _____
M.				Wildcat
K.				
Mz.				
Mq.				
V.				
S.				
S.				
A.				
R.				
PE.				
G.				
T.D.				

	0		
FIRST REPORT			
	NOV 2 '55		

Date Comm. OLD 2790 DD 3278

Co.
L.S.
No.
Sec.
T.
R.

County Butler Elev. 1287
 Sec. 15 Twp. 28 Rge. 5E
 Company R. H. Subr
 Farm Name Crowley "B" No. 1

Co.

TOPS	DEPTH	LOG	DATUM	Loc. in Sec.
Anh.				SE NE NW
Tp.				
H.				
Tr.				
Dg.				
Bl.				
L.				
K.C.	2143		856	Geol.
B.K.C.				Contr.
C.				White & Ell
M.	2749		1462	Pool
M.				Wildcat
K.				
Mz.				
Mq.				
V.				
S.				
S.				
A.	3191		1904	
R.				
Pe.				
G.				
T.D.	3792			

Use



D No.

Date Comm. NOV 9 1955

OTD 2790 DD 3278

D & A

Sec.

T.

R.