


Section 2 Township 14 Range 17 W

Well No. # 1 Braun

Company E. F. Wakefield

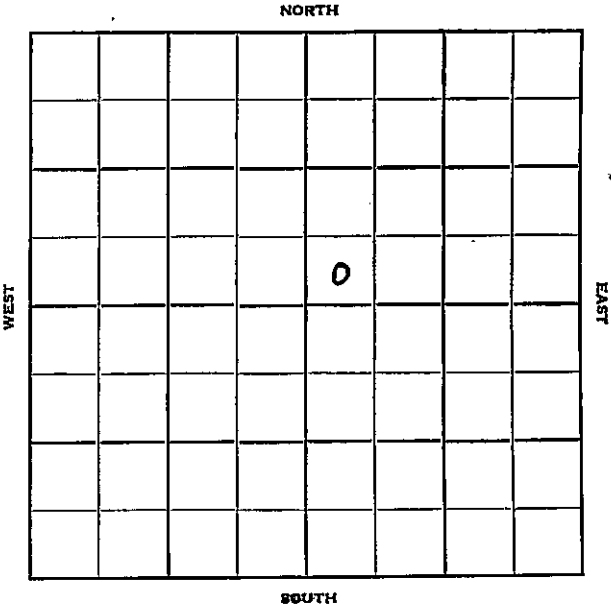

Ellis KANSAS

Sec. 2 Twp. 14 R. 17 W

Well No. # 1. Braun Farm

E. F. Wakefield Company

Wakefield. Contractor


 Ft. from N. Line

330 Ft. from S. Line

 Ft. from E. Line

330 Ft. from W. Line

SW SW NE

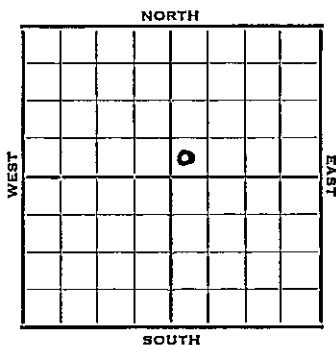

1952

Elev. 1942' REPORT

7/23

Spud 7-18-52
8" @ 150'
Shut down for repairs.


7/30

Drlg. 2420'

8/6

Spud 7-18-52
D & A TD 3600' 8" @ 150
KC 3214' B KC 3452' Arb. 3580'
TD 3600' D & A

ABANDONED

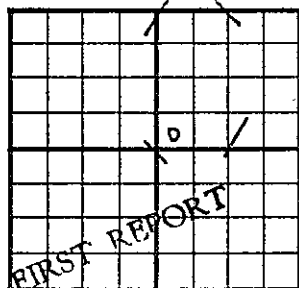County Ellis State KansasSec. 2 (Blk. 14 (Sur. 17W Map No. 17W)
(Twp.) (Rge.)Operator E. F. WakefieldWell No. 1 Farm BraunElev. Location SW SW NE330 Ft. From S Line NE330 Ft. From W Line Quarter1st. Report JUL 23 1952

Completion


Remarks

Wakefield - Contr.Spudding Date 7-18-52

Drlg. Data

8" @ 150 shut down for repairs

J. G. McGEHEE

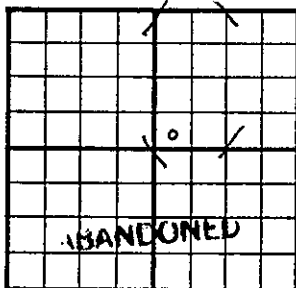County Ellis State KansasSec. 2 (Blk.
Twp.) 14 (Sur.
Rge.) 17W Map No.Operator E. F. WakefieldWell No. 1 Farm BraunElev. 1942 Location SW SW NE330 Ft. From S Line NE330 Ft. From W Line Quarter1st. ReportCompletion AUG 6 1952RemarksWakefield - Contr.Spudding Date 7-18-52Drilg. Data D & A TD 36008" @ 150 KC 3214 B KC 3452Arb. 3580 TD 3600D & A