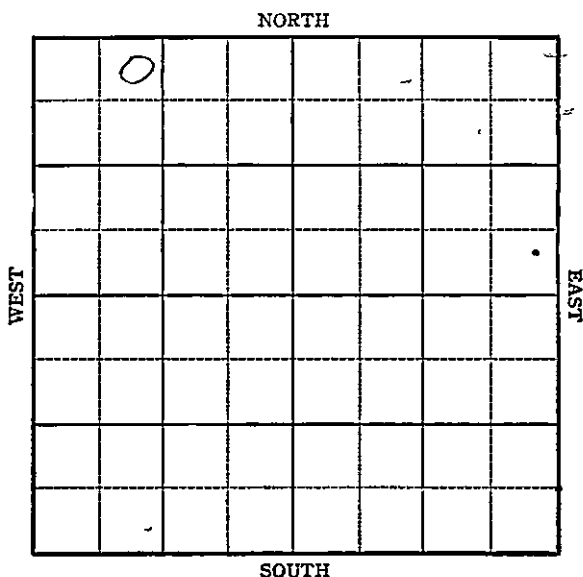


KANSAS

Ellis County

Section 23 Township 14 Range 17WWell No. #1 BraunCompany R. G. Piper et alJ. H. Wilson

Sec. 2 Twp. 14S R. 17W

Well No. #1 Braun Farm

~~J. H. Wilson~~ R. G. Piper et al Company


Toulon

330 Ft. from N. Line

_____ Ft. from S. Line

_____ Ft. from E. Line

990 Ft. from W. Line

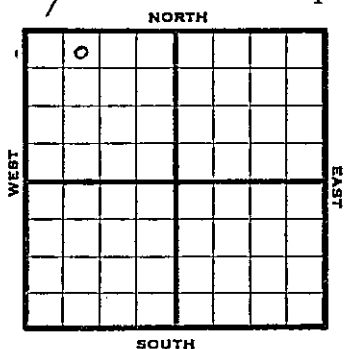

NE NW NW

1944 Elev. 1926 R E P O R T


11-8	12" @ 67'
	Drilling 215'
11-16	8" @ 1116'
	Anhy 1108'
	Drilling 1182'
11-24	Drilling 3068'
11-29	Topeka 2908'
	Lansing 3214
	Arbuckle 3451-3454
	Total Depth 3454'
	5" @ 3454
	Rigging up standard tools.
12-6	Arbuckle 3451'
	5" @ 3454
	Total Depth 3456
	Pump 45 Pot.
	Gravity 34.0

COMPLETED

Pool Name ToulonMap No. 71 Sec. 2 Twp. 14 R. 17WWell No. 1 BraunJ. H. Wilson CompanyFIRST REPORT Contractor

NE NW NW

SECTION PLAT

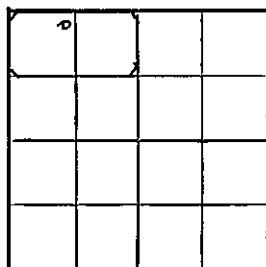330 Ft. from N. Line Ft. from S. Line Ft. from E. Line990 Ft. from W. LineEllisLocation Rig up

Drilling and Remarks:

12" - 67'215'

RECORD

Cased in., ft.Sand Gas Oil Total Depth

PRODUCTION

1st 24 hrs. Nat. 1st 24 hrs. after shot Gas Cu. Ft.Dry Hole Abandoned

Date

NOV 8 1944 19S. J. LEWIS Scout

Pool Name ToulonMap No. 71 Sec. 2 Twp. 14 R. 17WWell No. 1 BraunR. G. Piper et al CompanyCORRECTION Contractor

NE NW NW

SECTION PLAT

330			
990			

330 Ft. from N. Line Ft. from S. Line Ft. from E. Line990 Ft. from W. LineEllisLocation Rig up

Drilling and Remarks:

reported as
J. H. Wilson

RECORD

Cased in., ft.Sand Gas Oil Total Depth

PRODUCTION

1st 24 hrs. Nat. 1st 24 hrs. after shot Gas Cu. Ft.Dry Hole Abandoned

Date

DEC 6 1944 19 S. J. LEWIS Scout

Pool Name ToulonMap No. Sec. 2 Twp. 14 R. 17WWell No. 1 BraunR. G. Paper et al CompanyCOMPLETED Contractor

NE NW NW

SECTION PLAT

330 Ft. from N. Line Ft. from S. Line Ft. from E. Line990 Ft. from W. Line

0			

Ellis

Location Rig up

Drilling and Remarks:

CR 34515" 103454Pump 40 P.D.340/2

RECORD

Cased in., ft.Sand Gas Oil Total Depth 3456

PRODUCTION

1st 24 hrs. Nat. 1st 24 hrs. after shot Gas Cu. Ft.Dry Hole Abandoned

Date

DEC 6 1944 19 S. I. LEWIS Scout