
Ellis

KANSAS

SECTION 2 TOWNSHIP 14S RANGE 17W

WELL NO. #3 Braun "B"

COMPANY Piper Petroleum

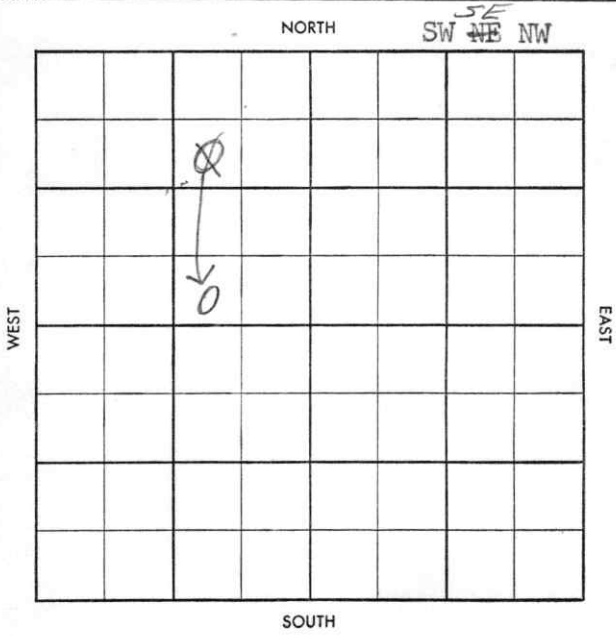

S-513-A

CO. Ellis ELEV.

SEC. 2 TWP. 14 RGE. 17W

COMPANY Piper Petroleum NO. 3

FARM Braun "B"

LOC. SW NE NW

GEOL.

CONTR. Thos. H. Allan

POOL Toulon

SPUD 10-25-57

8" @ 923 w/300, Drlg. 2150.

FIRST REPORT
OCT 30 57

CO. LSE. NO. SEC. TWP. RGE.

S-513-A

CORRECTION

CO. Ellis ELEV. 1976DF

SEC. 2 TWP. 14 RGE. 17W

COMPANY Piper Petroleum NO. 3

DEC 18 '57

COMPLETE

FARM Braun "B"

LOC. ~~SW NE NW~~ L+S ? SW SE NW

GEOL.

CONTR. Thos. H. Allan

POOL Toulon

SPUD 10-25-57

CO. LSE. NO. SEC. TWP. RGE.

8" @ 923 w/300, Drlg. 2150. NOV 6 57 A

1146-86 Hb 3189 Lsg 3244

DST 3255-85' 60" 2325 GIP

rec 60' HO+GCM 60' Mdy oil

240' oil BHP 740/20" DST

3300-20 60" G/53" 420' MO

BHP 640/20" DST 3320-40

NOV 13 57 60" 1000' GIA 140' HO+GCM

BHP 960/20" Art 3498 RTD 3492

5½ 3491/125 CO TD 3502

1 BOph NW not 300A

NOV 20 57 ~~$~~ 2 BOph NW NT

750A ~~$~~ 3 BOph NW not

PB 3347 5½ 3312-16

~~$~~ 2 BOph NW not NOV 27 57

P 91 BOpd NW

DEC 4 57

DEC 18 57

Lsg 3312-16