


Map No. K Sec. 31 Twp. 30 R. 6  
Well No. 1 Robbins Farm \_\_\_\_\_  
Levens dit Company \_\_\_\_\_

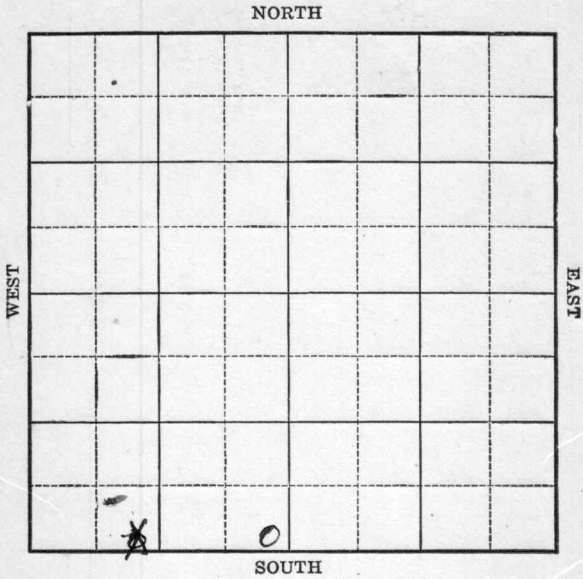

Location \_\_\_\_\_

Drilling Remarks:  
\_\_\_\_\_  
\_\_\_\_\_  
RECORD

Cased \_\_\_\_\_ in. \_\_\_\_\_ ft.  
Sand \_\_\_\_\_  
Gas \_\_\_\_\_  
Oil \_\_\_\_\_  
Total Depth \_\_\_\_\_

Rig Up \_\_\_\_\_

Drilling Remarks:  
\_\_\_\_\_  
\_\_\_\_\_  
PRODUCTION


1st 24 hrs. Nat. \_\_\_\_\_  
1st 24 hrs. after shot \_\_\_\_\_  
Gas \_\_\_\_\_ cu. ft.  
Dry Hole \_\_\_\_\_  
Abandoned \_\_\_\_\_

Map No. K Sec. 31 Twp. 30 R. 6Well No. 1 - Robbins FarmLevors Oil Company

Ft. from N. Line

330 Ft. from S. Line330<sup>1</sup> Ft. from E. Line.

Ft. from W. Line

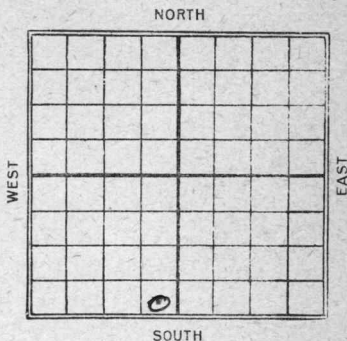

## REPORT

Date 1/9/244/24/245/22ReqDlg 1900'Top 6 and 2850'at. 2864-66. JD-flow 410 Bbls nat

Map No. KANSAS 11 Sec. 31 Twp. 30 R. 6  
Well No. 1 Ruffins  
Lewis oil Company  
Contractor

FIRST REPORT

SECTION PLAT

\_\_\_\_\_ Ft. from N. Line  
330 Ft. from S. Line  
330 Ft. from E. Line  
\_\_\_\_\_ Ft. from W. Line

|  |  |  |  |
|--|--|--|--|
|  |  |  |  |
|  |  |  |  |
|  |  |  |  |
|  |  |  |  |

Location \_\_\_\_\_  
Rig up \_\_\_\_\_  
Drilling and Remarks:

R.O.G.

RECORD

Cased \_\_\_\_\_ in., \_\_\_\_\_ ft.  
Sand \_\_\_\_\_  
Gas \_\_\_\_\_  
Oil \_\_\_\_\_  
Total Depth \_\_\_\_\_

PRODUCTION

1st 24 hrs. Nat. \_\_\_\_\_  
1st 24 hrs. after shot \_\_\_\_\_  
Gas \_\_\_\_\_ Cu. Ft.  
Dry Hole \_\_\_\_\_  
Abandoned \_\_\_\_\_

Date APR 2 1924 M. A. BENEAR  
\_\_\_\_\_ 192\_\_\_\_\_ Scout

11  
 Map No. ~~KAR348~~ Sec. 31 Twp. 30 R. 6
Well No. 1 RaffinsLewis Oil Company

Contractor

**COMPLETED****SECTION PLAT**

-----Ft. from N. Line

240 Ft. from S. Line200 Ft. from E. Line

-----Ft. from W. Line

|  |  |  |  |
|--|--|--|--|
|  |  |  |  |
|  |  |  |  |
|  |  |  |  |
|  |  |  |  |
|  |  |  |  |

Location -----

Rig up -----

Drilling and Remarks:

Tap 2750  
oil 2764-6670,  
flow 410 lb  
nat.

**RECORD**

Cased ----- in., ----- ft.

Sand -----

Gas -----

Oil -----

Total Depth -----

**PRODUCTION**

1st 24 hrs. Nat. -----

1st 24 hrs. after shot -----

Gas ----- Cu. Ft.

Dry Hole -----

Abandoned -----

Date

**MAY 22 1924****M. A. BENEAR**

-----192----- Scout