


Section 15 Township 28 Range 5E

Well No. #1 Crowley

Company Rex & Morris & Alan Van

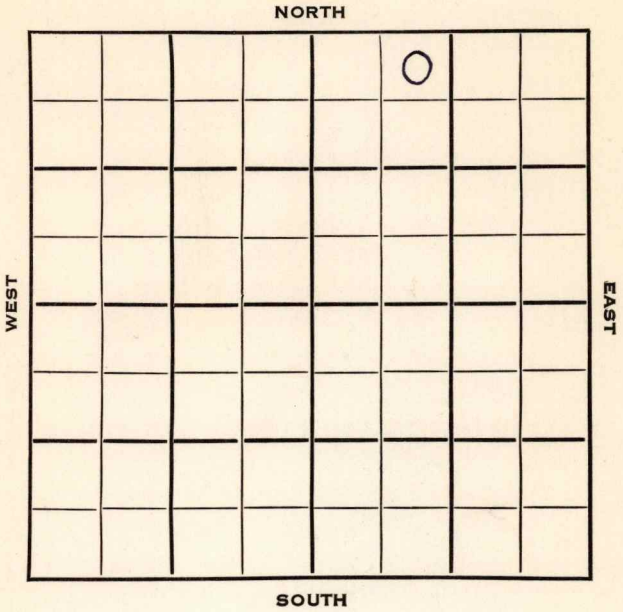

Sec. 15 Twp. 28 R. 5E

Well No. #1 Crowley Farm _____

Rex & Morris & Alan Van Company _____

Contractor _____


330 Ft. from N. Line

_____ Ft. from S. Line

_____ Ft. from E. Line

990 Ft. from W. Line

NE NW NE

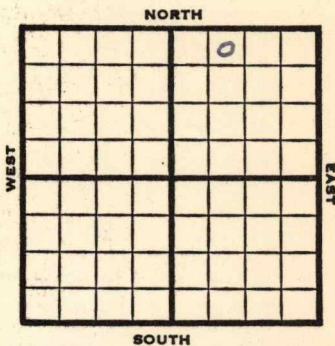

1953

Elev. 1297'

REPORT

8/19 Spud 8-17-53

9/2 Spud 8-17-53

D & A

TD 3213'

8" @ 105'

KC 2162, Miss 2748, B. Miss 3070,

Arb 3183

TD 3213'

D & A

ABANDONED

County **Butler** State **Kansas**

Sec. **15** (Blk. Twp.) **28** (Sur. Rge.) **5E** Map No.

Operator **Rex & Morris & Alan Van**

Well No. **1** Farm **Crowley**

Elev. Location **NE NW NE**

330 Ft. From **N** Line **NE**

990 Ft. From **W** Line **Quarter**

1st. Report **AUG 19 1953**

Completion

Remarks

Spudding Date **8-17-53**

FIRST REPORT

Drlg. Data

J. G. McGEHEE

