


Butler

Map No. **KANSAS** Sec. 21 Twp. 28 R. 5

Well No. 1-Ballein Farm
James Madison Company

NORTH

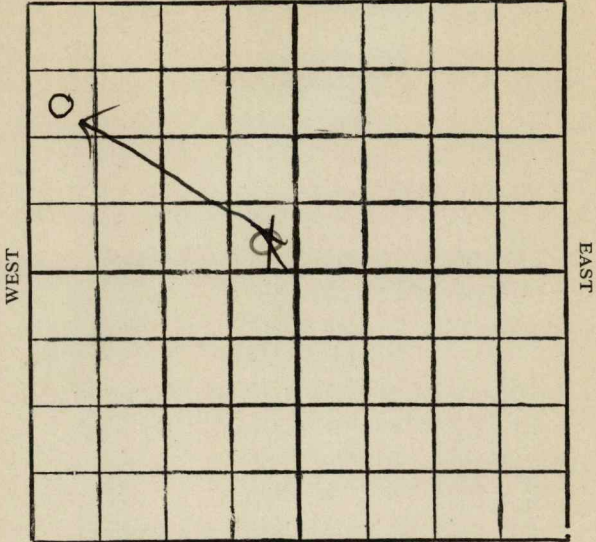

SOUTH

Location

Drilling Remarks

Rig Up

Drilling Remarks

RECORD

Cased.....in.ft.

Sand

Gas

Oil

Total Depth.....

PRODUCTION

1st 24 hrs. Nat.

1st 24 hrs. after shot.....

Gas..... cu. ft.


Dry Hole

Abandoned

KANSAS

Map No. KansasSec. 21 Twp. 28 R. 5Well No. 1 Bellein FarmJames Madison Company

NORTH

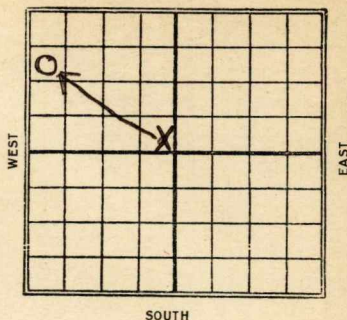990 Ft. from N. Line~~330~~ Ft. from S. Line~~330~~ Ft. from E. Line330 Ft. from W. Line

Date

REPORT

19274/27 location5/5 —5/12 —5/18 —5/25 —6/1 —6/7 —6/15 —6/22 Spudding 265'6/29 Drlg 5007/7 S.D. 500'7/13 —7/20 —7/28 —8/4 —8/10 Drlg 12008/18 " 1510'8/24 " 20109/1 S.D. 23059/7 S.D. 2440 - titles9/14 — 10/19 —9/29 — 10/12 —10/6 —

10/27 - S.D. 2440 titles

11/2 - _____

11/9 - _____

11/16 - _____

11/23 - _____

11/30 - _____

12/7 - _____

12/14 - _____

12/21 - Drlg 2650.

12/29 - Top line 2755 - drlg 2850.

1928
1/5 - Shut down 2950.

1/11 - Drlg 3025

1/18 - " 3150

1/26 - Top line 2755

Wilco 3198-3205

N. & A. 3205

11 **KANSAS** 21 Twp. 28 R. 5

Well No. 1 *Bullion*
James Madison Company

Contractor

FIRST REPORTS

SECTION PLAT

_____ Ft. from N. Line

320 _____ Ft. from S. Line

320 _____ Ft. from E. Line

_____ Ft. from W. Line

Location ☒

Rig up _____

Drilling and Remarks:

RECORD

Cased _____ in., _____ ft.

Sand _____

Gas _____

Oil _____

Total Depth _____

PRODUCTION

1st 24 hrs. Nat. _____

1st 24 hrs. after shot _____

Gas _____ Cu. Ft.

Dry Hole _____

Abandoned _____

Date

APR 27 1927

CHAS. L. SHERWOOD

192

Scout

Map No. 11 **KANSAS** Sec. 21 Twp. 38 R. 5 E

Well No. 1 Ballein
James Madison Company

Contractor

CORRECTION


SECTION PLAT

990 Ft. from N. Line

_____ Ft. from S. Line

_____ Ft. from E. Line

330 Ft. from W. Line

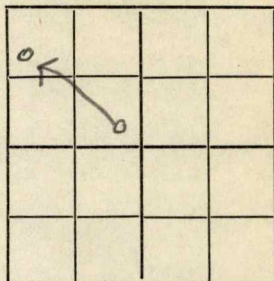

Location _____

Rig up _____

Drilling and Remarks:

SPD 265'

RECORD

Cased _____ in., _____ ft.

Sand _____

Gas _____

Oil _____

Total Depth _____

PRODUCTION

1st 24 hrs. Nat. _____

1st 24 hrs. after shot _____

Gas _____ Cu. Ft.

Dry Hole _____

Abandoned _____

Date _____

JUN 22 1927

CHAS. L. SHERWOOD

192

Scout

Map No. 11 **KANSAS** Sec. 21 Twp. 28 R. 5

Well No. 1 Ballein
James Madison Company

Contractor

COMPLETED

SECTION PLAT

990 Ft. from N. Line

_____ Ft. from S. Line

_____ Ft. from E. Line

330 Ft. from W. Line

ABANDONED

0			

Location _____

Rig up _____

Drilling and Remarks:

Top line 2755

Wilcox 3198-3205

229 3205

RECORD

Cased _____ in., _____ ft.

Sand _____

Gas _____

Oil _____

Total Depth 3205

PRODUCTION

1st 24 hrs. Nat. _____

1st 24 hrs. after shot _____

Gas _____ Cu. Ft.

Dry Hole ☒

Abandoned ☒

Date

JAN 26 1928

CHAS. L. SHERWOOD

192

Scout