


Section 19 Township 28 Range 5 E

Well No. # 1 Clark

Company Mallard Drlg. & C. A. Black

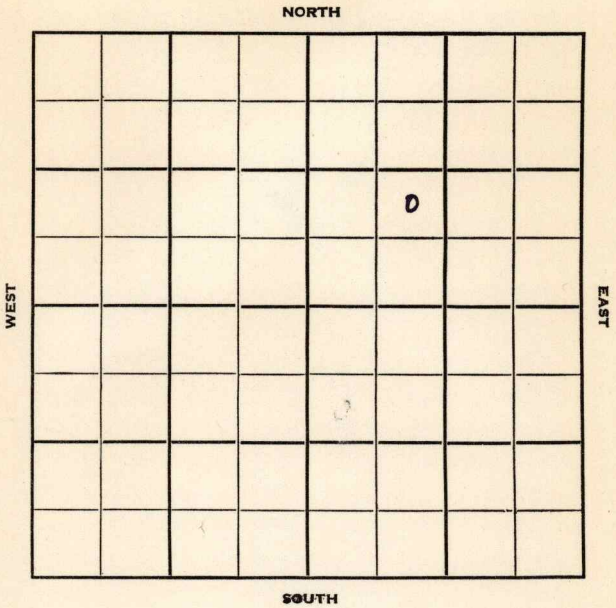

Butler

KANSAS

Sec. 19 Twp. 28 R. 5E

Well No. #1 Clark Farm

Mallard Drlg. & C.A. Black Company

Contractor

Wildcat


Ft. from N. Line

990' Ft. from S. Line

Ft. from E. Line

990' Ft. from W. Line

NE SW NE

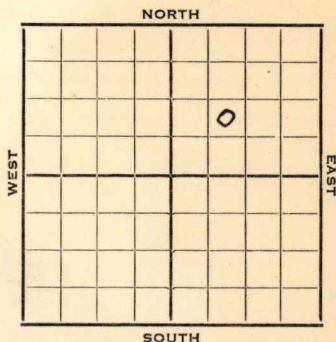

1952

Elev. 1227'

REPORT

3/19

Spud 3-13-52

8" @ 160

Drlg. 2270'

3/26

Spud 3-13-52

D & A TD 2800 8" @ 160

KC 2165' Ft. Scott 2527' Cherokee

sh. 2609' Miss 2763' TD 2800'

D & A

ABANDONED



