



Ellis

KANSAS.

Sec. 2 Twp. 14 R. 17W

Well No. #1 Kuhn Farm

Peel - Hardman Company

Contractor


Semi-Wildcat

330' Ft. from N. Line

\_\_\_\_\_ Ft. from S. Line

330' Ft. from E. Line

\_\_\_\_\_ Ft. from W. Line

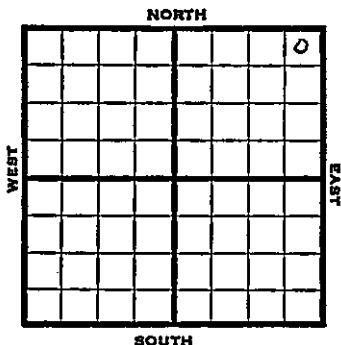

NE NE NE

1951

Elev. 1929' REPORT

6/13

RUR

6/27

Spud 6-13-51

D&A TD 3665

8" @ 250

Lans. 3209 Cong. 3595

Arb. 3633-65 TD

D&A

**ABANDONED**



