


Butler

KANSAS

SECTION 21 TOWNSHIP 28 RANGE 5 E

WELL NO. #1 Winzer

COMPANY Frank Strait

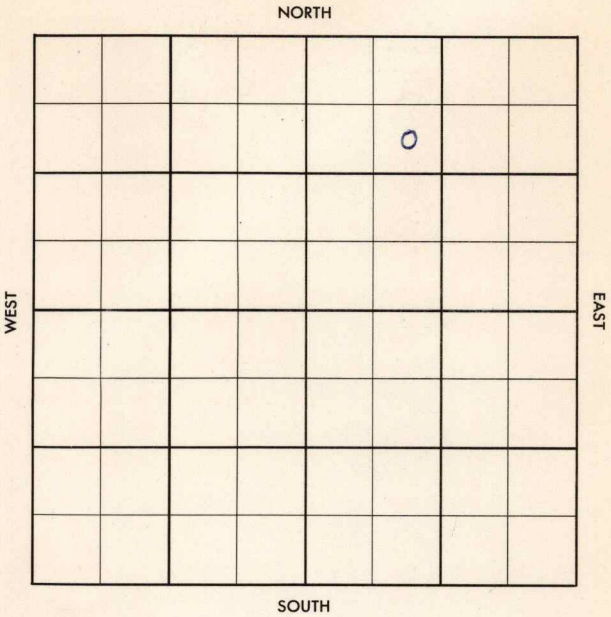

Butler

KANSAS

SEC.	TWP.	R.
21	28	5E

WELL NO.

#1 Winzer

FARM

COMPANY

Frank Strait

CONTRACTOR

Co Tools

Fox-Bush Pool


Ft. from N. Line

Ft. from S. Line

Ft. from E. Line

Ft. from W. Line

SE NW NE

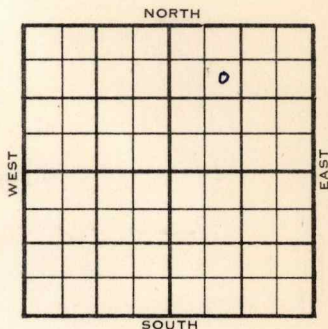

1955	ELEVATION	REPORT
	1308'	

11/2 Loc

12-14 Comm. 11-9-55

15 1/2" @ 375

13" @ 1112

10" @ 1740

8" @ 2370

D & A

L. 1840

KC 2170

M. 2760

TD 2820'

ABANDONED

County

~~Butler~~

Elev.

Sec.

~~21~~

Twp.

~~28~~

Rge.

~~5E~~

Company

~~Frank Strait~~

Farm Name

Winzer

No.

1

TOPS

DEPTH

LOG

DATUM

Loc. in Sec.

Anh.

SE NW NE

Tp.

H.

Tr.

Dg.

B.L.

L.

K.C.

B.K.C.

Ce.

C.

M.

M.

K.

Mz.

Ma.

V.

S.

S.

A.

R.

Pe.

G.

T.D.

Geol.

Contr.

Co. tools

Pool

Fox-Bash Pool

FIRST REPORT

NOV 2 '55

Date Comm.

Location

Co.

Lse.

No.

Sec.

T.

R.

County Butler Elev. 1308
 Sec. 21 Twp. 28 Rge. 5E
 Company Frank Strait
 Farm Name Winzer No. 1

TOPS	DEPTH	LOG	DATUM	Loc. in Sec.
Anh.				SE NW NE
Tr.				
Dg.				
Bl.				
L.	1840		532	Geol.
K.C.	2170		862	Contr.
B.K.C.				Co. tools
Ce.				Pool
C.	2760		1452	Box-Bush
M.				
M.				
K.				
Mz.				
Me.				
V.				
S.				
S.				
A.				
R.				
Pe.				
G.				
T.D.	2820			

Date Comm. 11-9-55 DEC 1 4 1955

15 $\frac{1}{2}$ " @ 375 13" @ 1112 10" @ 1740

8" @ 2370

D & A

ABANDONED