


Kansas

Map No. _____ Sec. 22 Twp. 28 R. 5Well No. 1 Cameron Farm _____Stone & Johnson Company _____

NORTH

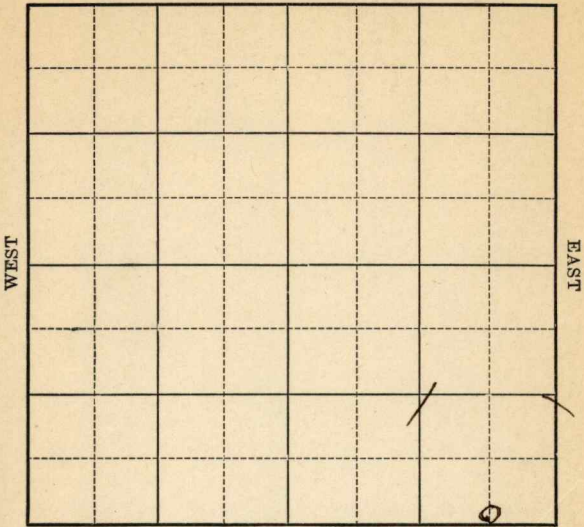

SOUTH

COMPLETED

Location _____

Drilling Remarks:

Rig Up _____

Drilling Remarks:

RECORD

Cased _____ in. _____ ft.

Sand _____

Gas _____

Oil _____

Total Depth _____

PRODUCTION

1st 24 hrs. Nat. _____

1st 24 hrs. after shot _____

Gas _____ cu. ft.

Dry Hole _____

Abandoned _____


Map No. _____ Sec. 22 Twp. 28 R. 5
Well No. #1 Cameron Farm
Stone & Johnson Company

_____ Ft. from N. Line

200 Ft. from S. Line

660 Ft. from E. Line

_____ Ft. from W. Line

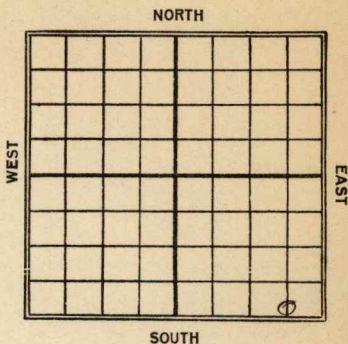

Date

REPORT

19227/22D 3009/16Sand 2770-85 - Shot 80
gts. D. & Q. 2890'

Map No. Kans 11 22 Sec. 22 Twp. 28 R. 5Well No. 1 CameronStone & Johnson Company

Contractor

FIRST REPORT

Ft. from N. Line

300'

Ft. from S. Line

660'

Ft. from E. Line

Ft. from W. Line

SECTION PLAT

			o

Location

Rig up

Drilling and Remarks:

10. 300'

RECORD

Cased _____ in., _____ ft.

Sand _____

Gas _____

Oil _____

Total Depth _____

PRODUCTION

1st 24 hrs. Nat. _____

1st 24 hrs. after shot _____

Gas _____ Cu. Ft.

Dry Hole _____

Abandoned _____

Date

JUL 22 1922

191

M. A. BENEAR

Scout

Map No. KANSAS Sec. 22 Twp. 28 R. 5Well No. 1 Cameron
Stone & Johnson Company
Contractor

ABANDONED SECTION PLAT

Ft. from N. Line

200 Ft. from S. Line660 Ft. from E. Line

Ft. from W. Line

			0

Location

Rig up

Drilling and Remarks:

shot 80 gals

RECORD

Cased _____ in., _____ ft.

Sand 2770-2785

Gas _____

Oil _____

Total Depth _____

PRODUCTION

1st 24 hrs. Nat. _____

1st 24 hrs. after shot _____

Gas _____ Cu. Ft.

Dry Hole ✓Abandoned 2890

Date

SEP 16 1922

191

M. A. BENEAR

Scout