


Section 22 Township 28 Range 5-E

Well No. #1 Crowley

Company E B Shawver

Miscellaneous

NORTH

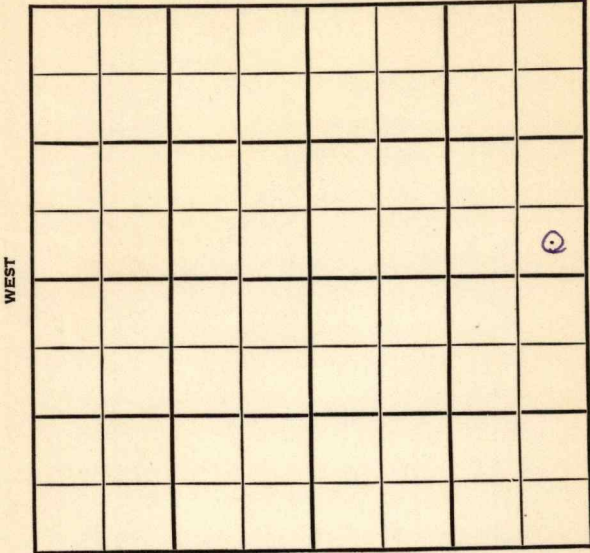

SOUTH

WEST

EAST

Sec. 22 Twp. 28 R. 5E

Well No. #1 Crowley Farm

E. B. Shawver Company

Misc.


Ft. from N. Line

330 Ft. from S. Line

330 Ft. from E. Line

Ft. from W. Line

SE NE

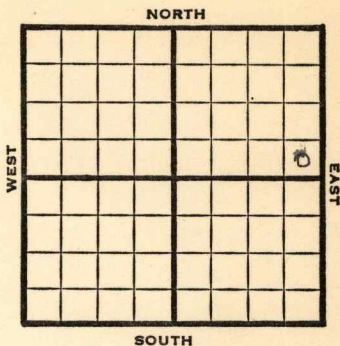

1948

E1 1323'

REPORT

6/1

8" @ 44'
Drlg. 2010'

6/9

KC 2175'
TD 2780'
5" @ 2765'

6/16

Bart 2765'
TD 2780'
20 qts 2770-80 CO

6/23

TD 2780'
Bart 2765'
5" @ 2765'
wtr.
Aband.

ABANDONED

Map No. _____ Sec. 22 Twp. 28 R. 5E

Well No. 1 Crowley

E. B. Shawver Company

FIRST REPORT

Contractor

SE NE

SECTION PLAT

_____ Ft. from N. Line

330 Ft. from S. Line

330 Ft. from E. Line

_____ Ft. from W. Line

			△

Butler County

Location _____

Rig up _____

Drilling and Remarks:

8" @ 44

drlg. 2010

RECORD

Cased _____ in., _____ ft.

Sand _____

Gas _____

Oil _____

Total Depth _____

PRODUCTION

1st 24 hrs. Nat. _____

1st 24 hrs. after shot _____

Gas _____ Cu. Ft.

Dry Hole _____

Abandoned _____

Date

JUN 1 1948 19

S. J. LEWIS Scout

