


Section 15 Township 28 Range 5 E

Well No. # 1 Crowley

Company R. H. Suhr (Colo.)

NORTH

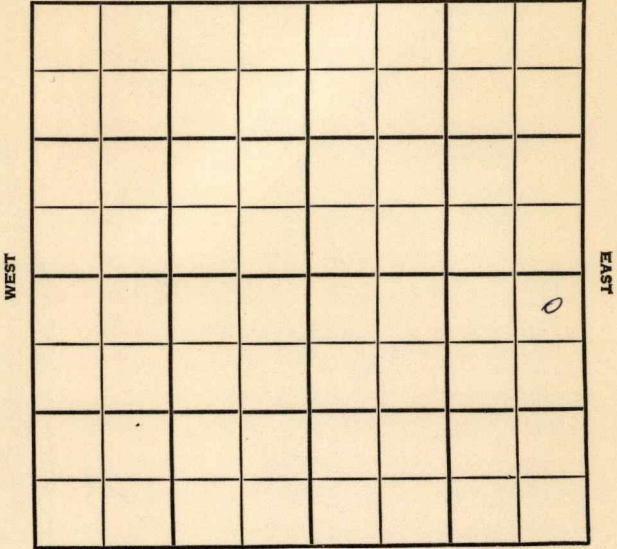

SOUTH

WEST

EAST

Butler

KANSAS


SEC.	TWP.	R.
15	28	5 E

WELL NO. # 1 Crowley FARM

COMPANY R. H. Suhr (Colo)

CONTRACTOR Malonee

330 Ft. from N. Line  
 \_\_\_\_\_ Ft. from S. Line  
 330 Ft. from E. Line  
 \_\_\_\_\_ Ft. from W. Line

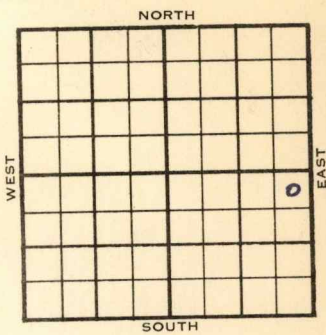

NE NE SE (Twin)

	ELEVATION	REPORT
1955	1262'	

5/25 D & A TD 3460 KC 2102'  
 Bart 2666-89 Miss 2704  
 DST 2705-24 open 45 min rec 20' mud  
 520#  
 DST 3126-46, open 1 hr rec 1080' sul.  
 wtr. 1000# Arb. 3250'  
 TD 3460' D & A

**FIRST REPORT**  
 ↓  
**ABANDONED**


County Butler State Kansas  
 Sec. 15 (Blk. Twp.) 28 (Sur. Rge.) 5E Map No.  
 Operator R. H. Suhr (Colo.)  
 Well No. 1 Farm Crowley  
 Elev. 1262 Location NE NE SE (twin)


FIRST REPORT  
 ABANDONED

330 Ft. From N Line SE  
330 Ft. From E Line Quarter  
 1st. Report MAY 25 1955  
 Completion \_\_\_\_\_  
 Remarks Malonee - Contr.  
 Spudding Date \_\_\_\_\_

Drlg. Data D & A TD 3460  
KC 2102 Bart. 2866-89 Miss. 2704  
DST 2705-24 open 45 min. Rec. 20' mud  
520# DST 3126-46 open 1 hr. Rec.  
1080' sul. wtr. 1000# Arb. 3250  
TD 3460

D & A

(Crest Pet. #1 Crowley (TD-2722) is located here as a dry oil well.)

NOTE:

This is a twin to Crest Pet. dry hole

WILL YOU PLEASE CHECK THE TOWNSHIP  
ON THIS WELL. THE MAPPING DEPARTMENT  
HAVE QUESTIONED SAME. THANKS. ALSO  
SEE THEIR NOTATION ON FRONT OF TICKET.

H. Morley  
Scouting Dept.

MAY 31 1955

Acct Cards *mm*  
Land Small Map  
Land Wall Map  
Tracings  
Service Map  
Pierce Map  
Misc.

Orig. Data