


Map No. 11 Sec. 31 Twp. 30 R. 6

Well No. 1-Walker Farm _____
Service Oil Company _____

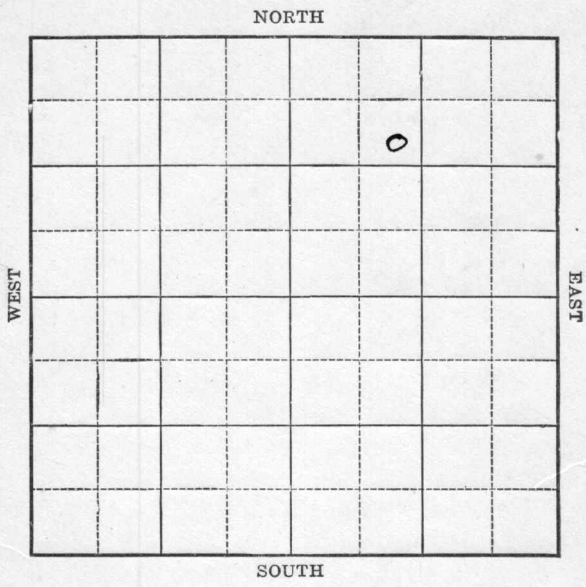

Location _____

Rig Up _____

Drilling Remarks:

Drilling Remarks:

RECORD

PRODUCTION

Cased _____ in. _____ ft.

Sand _____

Gas _____

Oil _____

Total Depth _____

1st 24 hrs. Nat. _____

1st 24 hrs. after shot _____

Gas _____ cu. ft.


Dry Hole _____

Abandoned _____

Map No. K Sec. 31 Twp. 30 R. 6

Well No. 1 Walker Farm
Lewis Oil Company

960 Ft. from N. Line
 _____ Ft. from S. Line
 _____ Ft. from E. Line
1060 Ft. from W. Line

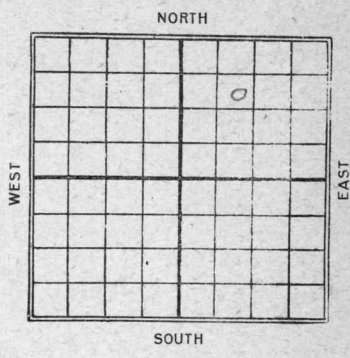

Date	REPORT
1924	
8/6	Rig up
10/28	Dug at 2953 Top line
11/28	Gas 2863-97 144 Gas
	Sand 2897-2900 sho oil
	Top Line 2953 D.T.G. 2953'

Map No. **KANSAS** 11 Sec. **31** Twp. **30** R. **6**

Well No. **1 Walker**

Lewis oil Company

Contractor

FIRST REPORT

SECTION PLAT

960 Ft. from N. Line

_____ Ft. from S. Line

_____ Ft. from E. Line

1060 Ft. from W. Line

		o	

Location _____

Rig up

Drilling and Remarks:

RECORD

Cased _____ in., _____ ft.

Sand _____

Gas _____

Oil _____

Total Depth _____

PRODUCTION

1st 24 hrs. Nat. _____

1st 24 hrs. after shot _____

Gas _____ Cu. Ft.

Dry Hole _____

Abandoned _____

Date _____

AUG 6 1924

M. A. BENEAR

192

Scout

Map No. **11 KANSAS** Sec. **31** Twp. **30** R. **6 E**

Well No. **1 Walker**

Lewis Oil Company

Contractor

ABANDONED SECTION PLAT

960 Ft. from N. Line

_____ Ft. from S. Line

_____ Ft. from E. Line

1060 Ft. from W. Line

		●	

Location _____

Rig up _____

Drilling and Remarks:

Gas sand 2863-97
1-M. gas
sand 2897-2900
show oil
Tap line 2953
LO + A 2953

RECORD

Cased _____ in., _____ ft.

Sand _____

Gas _____

Oil _____

Total Depth _____

PRODUCTION

1st 24 hrs. Nat. _____

1st 24 hrs. after shot _____

Gas _____ Cu. Ft.

Dry Hole _____

Abandoned _____

Date

NOV 28 1924

M. A. BENEAR

_____ 192 _____

_____ Scout