

Map No. _____ Sec. 22 Twp. 28 R. 5


Well No. #1 L. Craig Farm _____
Lewis Oil Company _____
20' East old hole

200 Ft. from N. Line

_____ Ft. from S. Line

180 Ft. from E. Line

_____ Ft. from W. Line

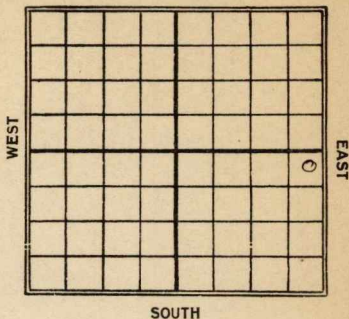

Date

REPORT

1922

7/22

Rig

9/16 Sand 2767-2786 - Shot
30gts. 25 Bblo.

Map No. Kans 22 Sec. 22 Twp. 28 R. 5

Well No. 1 R. E. Craig
Lewis oil Company

Contractor

20' East old
hole

SECTION PLAT

200 Ft. from N. Line

_____ Ft. from S. Line

180 Ft. from E. Line

_____ Ft. from W. Line

Location _____

Rig up _____

Drilling and Remarks:

Rig

RECORD

Cased _____ in., _____ ft.

Sand _____

Gas _____

Oil _____

Total Depth _____

PRODUCTION

1st 24 hrs. Nat. _____

1st 24 hrs. after shot _____

Gas _____ Cu. Ft.

Dry Hole _____

Abandoned _____

Date

JUL 22 1922

191

M. A. BENEAR

Scout

Map No. **KANSAS** Sec. **22** Twp. **28** R. **5**

Well No. **1 Craig**
Lewis O & I Company

Contractor

COMPLETED SECTION PLAT

200 Ft. from N. Line
 ----- Ft. from S. Line
200 Ft. from E. Line
 ----- Ft. from W. Line

			⊙

Location -----

Rig up -----

Drilling and Remarks:

shot 30qft

RECORD

Cased ----- in., ----- ft.
 Sand -----
 Gas -----
 Oil **2767-2786**
 Total Depth **2786**

PRODUCTION

1st 24 hrs. Nat. -----
 1st 24 hrs. after shot **23**
 Gas ----- Cu. Ft.
 Dry Hole -----
 Abandoned -----

Date

SEP 16 1922

191

M. A. BENEAR

Scout