

Sec. 32 Twp. 13 R. 14 W

Well No. # 5 Boxberger Farm

El Dorado Ref. Company

Aylward Drlg. Contractor

Russell Pool


_____ Ft. from N. Line

990 Ft. from S. Line

990 Ft. from E. Line

_____ Ft. from W. Line

NW SE SW

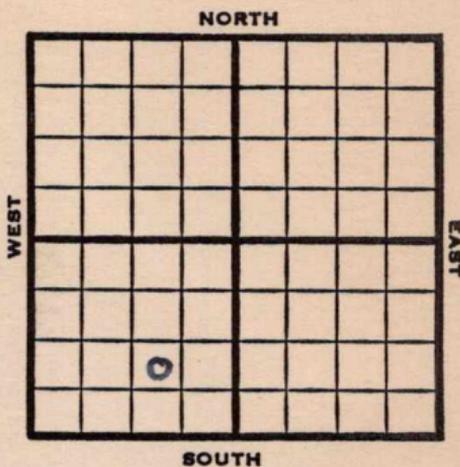

1953

Elev. 1860' REPORT

3/11

RUR

3/19

8" @ 320

Drlg. 2850'

3/26

RTD 3309

5" @ 3302

4/1

Spud 3-12-53

Oil Well

TD 3309'

8" @ 320

Heeb 2974, Tor 2992, Lans 3028, Arb 3299,

DST 3299-3302 open 1 hr. Rec 5' mud

0# DST 3300-3305 open 1 hr. Rec 7' mud
800#

DST 3300-09 open 1/2 hr. Rec 560' oil
10' ho & gcm 1000#

TD 3309'

5" @ 3302

CO to 3309 S/ 12 boph 3% wtr. 6 hr.

Comp. 200 bopd 3% wtr.

COMPLETED

