


Kansas

Map No. _____ Sec. 23 Twp. 28 R. 5Well No. 2 Craig Farm _____S. & S. Company _____

NORTH

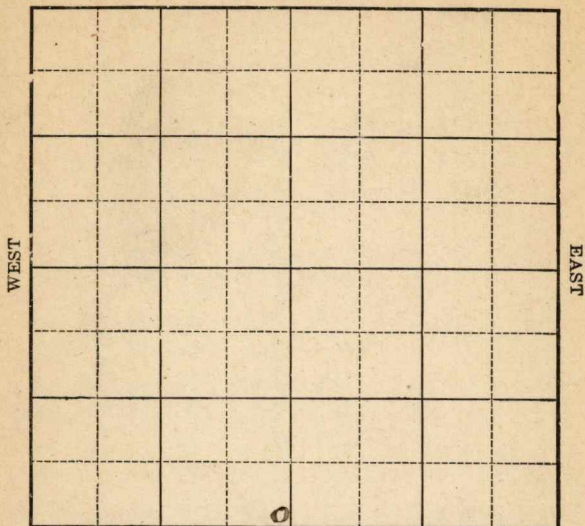

SOUTH

Location _____

Drilling Remarks:

Rig Up _____

Drilling Remarks:

RECORD

Cased _____ in. _____ ft.

Sand _____

Gas _____

Oil _____

Total Depth _____

PRODUCTION

1st 24 hrs. Nat. _____

1st 24 hrs. after shot _____

Gas _____ cu. ft.

Dry Hole _____


Abandoned _____

Map No. _____ Sec. 23 Twp. 28 R. 5Well No. 2 Craig Farm _____
S. & S. Company _____

_____ Ft. from N. Line

200 Ft. from S. Line200 Ft. from E. Line

_____ Ft. from W. Line

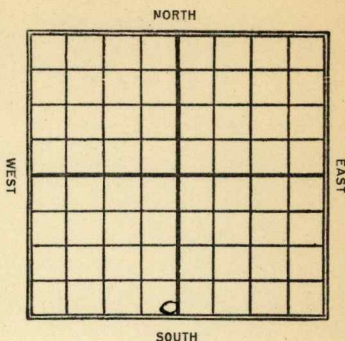

Date

REPORT

3/12Dry. 7253/301125'5/21Dry & Abd 2809'

Map No. K11 Sec. 23 Twp. 28 R. 5Well No. 3 Original

_____ Company

_____ Contractor

FIRST REPORT

SECTION PLAT

_____ Ft. from N. Line

200 Ft. from S. Line200 Ft. from E. Line

_____ Ft. from W. Line

Location _____

Rig up _____

Drilling and Remarks:

20 lg-725'

RECORD

Cased _____ in., _____ ft.

Sand _____

Gas _____

Oil _____

Total Depth _____

PRODUCTION

1st 24 hrs. Nat. _____

1st 24 hrs. after shot _____

Gas _____ Cu. Ft.

Dry Hole _____

Abandoned _____

Date

MAR 12 1922

191

M. A. BENEAR

Scout

11 Kans Sec. 23 Twp. 28 R. 5

Well No. 2 Craig

Company

Contractor

ABANDONED

SECTION PLAT

-----Ft. from N. Line

200 Ft. from S. Line

200 Ft. from E. Line

-----Ft. from W. Line

Location -----

Rig up -----

Drilling and Remarks:

L + A

2809

RECORD

Cased ----- in., ----- ft.

Sand -----

Gas -----

Oil -----

Total Depth -----

PRODUCTION

1st 24 hrs. Nat. -----

1st 24 hrs. after shot -----

Gas ----- Cu. Ft.

Dry Hole -----

Abandoned -----

Date

MAY 21 1922

M. A. BENEAR

-----191-----

-----Scout