


Section 32 Township 13 Range 11W

Well No. #7 Boxberger "A"

Company Cities Service Oil

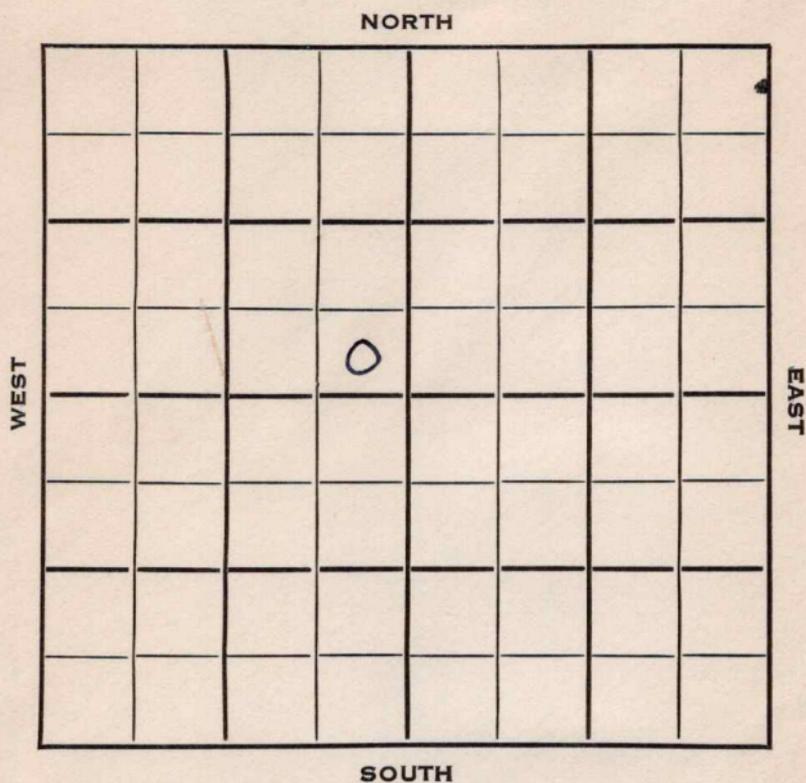

Russell

KANSAS ✓

Sec. 32 Twp. 13 R. 14W

Well No. #7 Boxberger "A" Farm

Cities Service Oil Company

Contractor


Ft. from N. Line

330 Ft. from S. Line

330 Ft. from E. Line

Ft. from W. Line

SE SE NW

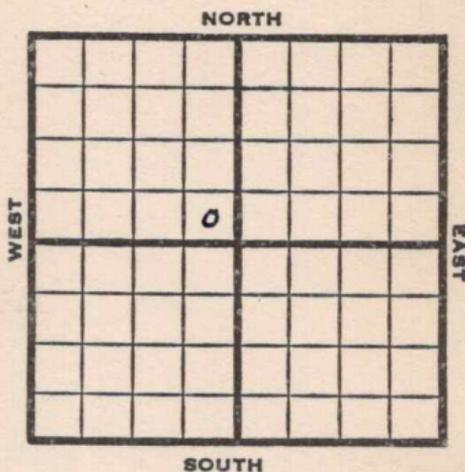

1953 **Elev. 1860'** REPORT

8/19 Location

8/26 8" @ 608'
Drlg 1905'

9/16 Spud 8-19-53 Oil well TD 3303
 8" @ 608 Top 2747 Heeb 2977
 Dodge 2994 Lans 3029 EroArb. 3294
 Arb. 3298 TD 3302
 DST 3299-3302 open 40 min rec 3' oil
 27' OCM 1005# 5" @ 3299
 DD 3303 500 A
 Comp. 239 BOPD 5BW

COMPLETED

