


Kansas

Map No. _____ Sec. 23 Twp. 28 R. 5

Well No. 3 Craig Farm _____

S. & S. Company _____

NORTH

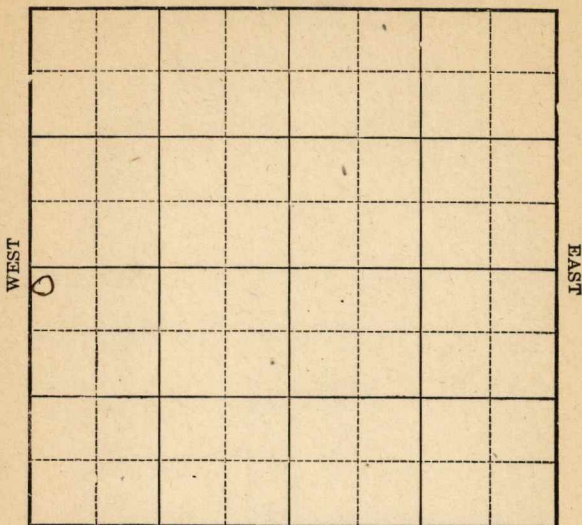

SOUTH

FIRST REPORT

Location _____

Drilling Remarks:

Rig Up _____

Drilling Remarks:

COMPLETED

RECORD

Cased _____ in. _____ ft.

Sand _____

Gas _____

Oil _____

Total Depth _____

PRODUCTION

1st 24 hrs. Nat. _____

1st 24 hrs. after shot _____

Gas _____ cu. ft.


Dry Hole _____

Abandoned _____

Map No. _____ Sec. 23 Twp. 28 R. 5Well No. 3 Craig Farm _____
S. & S. Company _____200 Ft. from N. Line

_____ Ft. from S. Line

_____ Ft. from E. Line

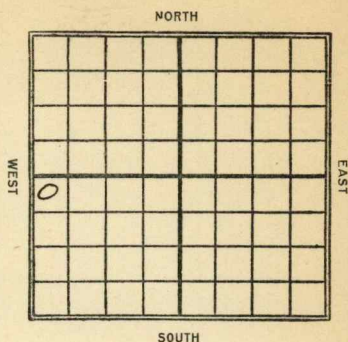200 Ft. from W. LineDate
1922

REPORT

10/26Rig12/3D. & A. 2850

Map No. **KANSAS** 11 Sec. **23** Twp. **28** R. **5**Well No. **3 Craig**

Company

Contractor

FIRST REPORT

SECTION PLAT

200 Ft. from N. Line

Ft. from S. Line

Ft. from E. Line

200 Ft. from W. Line

0			

Location

Rig up

Drilling and Remarks:

RECORD

Cased _____ in., _____ ft.

Sand _____

Gas _____

Oil _____

Total Depth _____

PRODUCTION

1st 24 hrs. Nat. _____

1st 24 hrs. after shot _____

Gas _____ Cu. Ft.

Dry Hole _____

Abandoned _____

Date

OCT 26 1922

M. A. BENEAR

191

Scout

Map No. **KANSAS** ¹¹ Sec. **23** Twp. **28** R. **5**Well No. **3 Craig***Shaner & Smith* Company

Contractor

ABANDONED**SECTION PLAT****200** Ft. from N. Line

Ft. from S. Line

Ft. from E. Line

200 Ft. from W. Line

Location

Rig up

Drilling and Remarks:

RECORD

Cased _____ in., _____ ft.

Sand _____

Gas _____

Oil _____

Total Depth _____

PRODUCTION

1st 24 hrs. Nat. _____

1st 24 hrs. after shot _____

Gas _____ Cu. Ft.

Dry Hole *✓✓*Abandoned **2850**

Date

DEC 3 1922**M. A. BENEAR**

191

Scout