

KANSAS

Map No. Kans 36 Sec. 36 Twp. 30 R. 6

Well No. 1-Marshall Farm

~~John Herson et al~~ Company

Luett & Sheets

NORTH

WEST

EAST

SOUTH

OWDD

Location

Drilling Remarks

Rig Up

Drilling Remarks

RECORD

Cased in. ft.

Sand

Gas

Oil

Total Depth

PRODUCTION

1st 24 hrs. Nat.

1st 24 hrs. after shot

Gas cu. ft.

Dry Hole

Abandoned

KANSAS

Map No. Kans Sec. 36 Twp. 30 R. 6Well No. 1-Marshall FarmJohn Herron state companyLuetth & Sheets NORTH


Ft. from N. Line

330 Ft. from S. Line

Ft. from E. Line

330 Ft. from W. Line1926

WEST

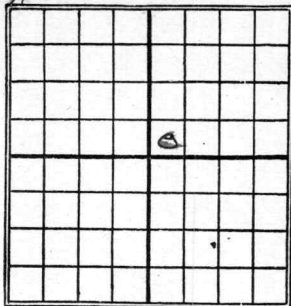

SOUTH

Date

REPORT

OWDD

10/27	timbers
11/11	same
11/17	Spudding
11/23	Drlg 300'
12/8	S.D. 470
12/15	same
12/22	—
12/30	—
1927	
1/6	—
1/13	—
1/19	—
1/26	—
2/3	—
2/10	—
2/17	—
2/24	—
3/2	—
3/9	—
3/16	—
3/24	S.D. 470
3/30	—

(over)

4/7 - S.D. 470	1928	
4/13 -		1/5 - S.D. 470
4/20 -		1/11 -
4/27 -		1/18 -
5/5 -		1/26 -
5/12 -		2/2 -
5/18 -		4/9 - Drlg 1115 -
5/25 -		4/16 - Show oil 1135-42
6/1 -		Show - S.D. 1255 for fuel
6/7 -		7/23 - Drlg 1360. Show oil
6/15 -		" 1545
6/22 -	3/1 -	" S.D. 1645
6/29 -	3/8 -	Drlg 1685 -
7/7 -	3/16 -	S.D. 1685
7/13 -	3/22 -	
7/20 -	3/29 -	
7/28 -	4/5 -	
8/4 -	4/12 -	
8/10 -	4/19 -	
8/18 -	4/26 -	
8/24 -	5/3 -	S.D. 1834
9/1 -	5/10 -	
9/7 -	5/18 -	Drlg 2000 -
9/14 -	5/24 -	
9/29 -	5/31 -	Drlg 2875 -
10/6 -	4/1 -	6" - 2902 - top line
10/12 -		+ pay 2928 - 34. hole
10/19 -		full oil -
10/27 -	4/4 -	Swab 60 bbls +
11/2 -		Swabbed down -
11/9 -		run'g 2" tubing
11/16 -	6/21 -	U.R. 6" to 2916 -
11/23 -	6/28 -	Shot 40 qts - Swab
11/30 -		40 bbls + water broke in -
12/7 -	7/6 -	Pumping 60 bbls -
12/14 -	7/13 -	2928 - 2934
12/21 -		T.O. 2934
12/29 -		40/40 bbls oil
		20 " water


Map No. KANSAS Sec. 36 Twp. 30 R. 6
Well No. 1-Marshall Farm
Luett & Sheet Company

_____ Ft. from N. Line

330 Ft. from S. Line

_____ Ft. from E. Line

330 Ft. from W. Line

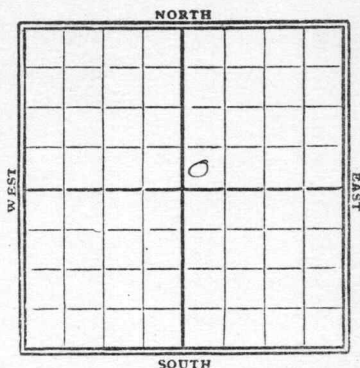

1929

Date	REPORT
	OWDD old TD 2933
2/13	Rgn up to deeper
2/20	
2/27	drlg 3100'
3/6	fsg 3130'
3/13	
3/20	
3/27	
4/3	drlg 3215'
4/10	" 3220'
4/17	HFW- 3288-3307 S.D
4/24	
5/1	
5/8	
5/15	Base line 3216'
	HFW 3288-3307
	T.D. 3307
	Dry & Abandoned

11 KANSAS 36 30 6
 Map No. Sec. Twp. R.

Well No. 1 Marshall

John Heron et al Company

Contractor

FIRST REPORTS

Ft. from N. Line

330 Ft. from S. Line

Ft. from E. Line

330 Ft. from W. Line

SECTION PLAT

Location

Rig up

Drilling and Remarks:

RECORD

Cased in, ft.

Sand

Gas

Oil

Total Depth

PRODUCTION

1st 24 hrs. Nat.

1st 24 hrs. after shot

Gas Cu. Ft.

Dry Hole

Abandoned

Date

OCT 27 1926

192

CHAS. L. SHERWOOD

Scout

MAP No. K11 Kansan SEC. 36 TWP. 30 R. 6

WELL No. 1 Marshall
John Herrow et al COMPANY

CONTRACTOR

COMPLETED

SECTION PLAT

Ft. FROM N. LINE

330

Ft. FROM S. LINE

Ft. FROM E. LINE

330

Ft. FROM W. LINE

LOCATION _____

RIG UP _____

DRILLING AND REMARKS:

40 40 B&S
20 B&S water

RECORD

CASED _____ IN. _____ FT.

SAND 2928-2934

GAS _____

OIL _____

TOTAL DEPTH 2934

PRODUCTION

1ST 24 HRS. NAT. _____

1ST 24 HRS. AFTER SHOT _____

GAS _____ Cu. Ft.

DRY HOLE _____

ABANDONED _____

DATE

7/13/28

192

Sherwood

SCOUT

Cowley
 H11 **KANSAS** Sec. *36* Twp. *30* R. *6*
 Well No. *1* *Marshall*
Lentt & *Sheets* Company

Contractor

FIRST REPORTS

SECTION PLAT

		o	

Ft. from N. Line

330 Ft. from S. Line

Ft. from E. Line

330 Ft. from W. Line*"Old Well Deeper"*

Location

Rig up *J.D. 2933'*

Drilling and Remarks:

*Rigging up to deepen**Formerly John Herron*

RECORD

Cased.....in.,ft.

Sand.....

Gas.....

Oil.....

Total Depth.....

PRODUCTION

1st 24 hrs. Nat.....

1st 24 hrs. after shot.....

Gas.....Cu. Ft.

Dry Hole.....

Abandoned.....

Date

FEB 13 1929

CHAS. L. SHERWOOD

192.....

Scout

Cowley

Map No. **KANSAS** Sec. **36** Twp. **30** R. **6**Well No. **Marshall**
Leutt & Sheets Company

Contractor

COMPLETE**SECTION PLAT**

		0	

Ft. from N. Line

330

Ft. from S. Line

Ft. from E. Line

330

Ft. from W. Line

ABANDONED

Location

Rig up

Drilling and Remarks:

Base L 3216

HFW 3288-3307

RECORD

Cased in., ft.

Sand

Gas

Oil

Total Depth **3307****PRODUCTION**

1st 24 hrs. Nat.

1st 24 hrs. after shot

Gas Cu. Ft.

Dry Hole

Abandoned

Date

MAY 15 1929

192

CHAS. L. SHERWOOD

Scout