

# KANSAS

Ellis


FORM 51 SM 2-38 TPCO.

11

Section 3 - Township 14 Range 17-W

Well No. #2-Braun


Company Watchorn

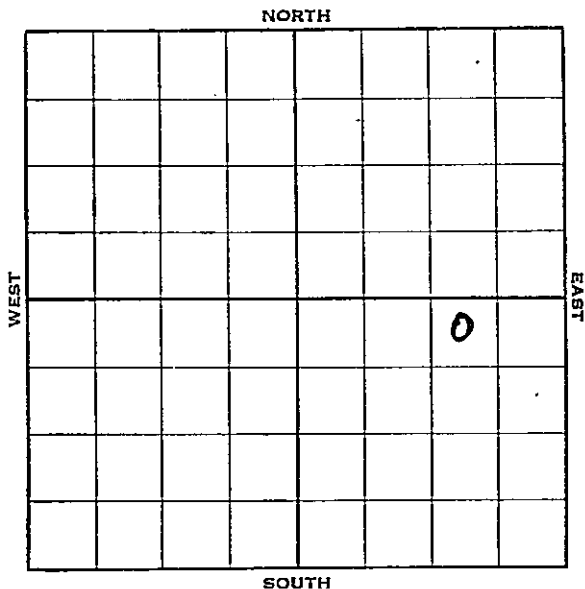

Sec. 3 Twp. 14 R. 17-W

Well No. #2 Braun Farm  
Watchorn Company

330 Ft. from N. Line  
 \_\_\_\_\_ Ft. from S. Line  
990 Ft. from E. Line  
 \_\_\_\_\_ Ft. from W. Line

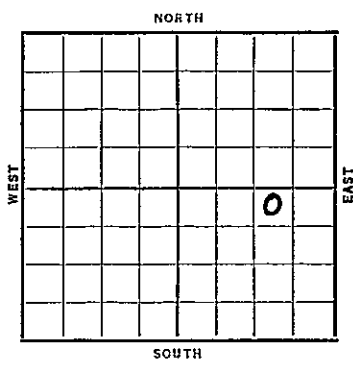

Elev. 1986

Date	REPORT
1938	
10/19	10" - 197'. Anhy. 1168'. Drlg. 2485'.
10/28	Dlgs. 3218'.
11/4	Lans. 3270'. Arb. 3500'. T. D. 3505'. S. O. Rng. 7".
11/12	7" - 3500'. 80' oil. 2000 acid.
11/16	7" - 3500'. Arb. 3500'. T. D. 3505'. 6000 acid.
	Potential 569 bbls.
	COMPLETED



Map No. 71 Sec. 3 Twp. 14 R. 17WWell No. 2 BraunWatchorn

Company

Contractor

## COMPLETED

NW NE SE

330 Ft. from N. Line

\_\_\_\_\_ Ft. from S. Line

990 Ft. from E. Line

\_\_\_\_\_ Ft. from W. Line

## SECTION PLAT

			0

Location \_\_\_\_\_

Rig up \_\_\_\_\_

Drilling and Remarks:

6000 acidLot 569

## RECORD

Cased 7 in., 3500 ft.Sand Arb 3500

Gas \_\_\_\_\_

Oil \_\_\_\_\_

Total Depth 3505

## PRODUCTION

1st 24 hrs. Nat. \_\_\_\_\_

1st 24 hrs. after shot \_\_\_\_\_

Gas \_\_\_\_\_ Cu. Ft.

Dry Hole \_\_\_\_\_

Abandoned \_\_\_\_\_

Date

NOV 16 1938 19

H. D. Hatfield Scout