


Section 36 Township 30 Range 6-E

Well No. 1 Snodgrass

Company Barnsdall

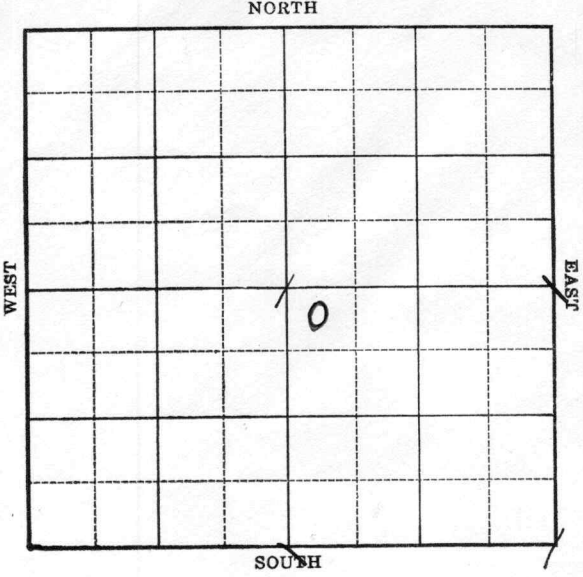

Sec. 36 Twp. 30 R. 6-E

Well No. #1 Snodgrass Farm
Barnsdall Company


330 Ft. from N. Line

_____ Ft. from S. Line

_____ Ft. from E. Line

330 Ft. from W. Line

Elev. 1409

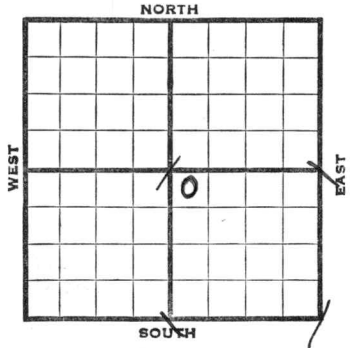

1938	REPORT
11/30	C. R.
12/9	Spud.
12/15	Drlg. 580'.
12/23	Drlg. 1375'.
12/30	12" - 1370'. Drlg. 1500'.
1939	
1/6	" " " " "
1/13	10" - 1502'. Drlg. 1725'.
1/20	" " " " "
1/27	8" - 1930'. K. C. 2150'. Drlg. 2235'.
2/3	6" - 2880'. Drlg. 2890'.
2/8	6" - 2889'.
	Miss. 2900'.
	T. D. 3000'.
	S. O. 2900-06 2916-20
	1/4 B.W. 2965-70'.
	ABANDONED

Map No. // Sec. 36 Twp. 30 R. 6E

Well No. 1 Snodgrass

Barnsdall

Company

Contractor

FIRST REPORT

NW SE

330 Ft. from N. Line

Ft. from S. Line

Ft. from E. Line

330 Ft. from W. Line

SECTION PLAT

		0	

Location

Rig up

Drilling and Remarks:

CR

RECORD

Cased in., ft.

Sand

Gas

Oil

Total Depth

PRODUCTION

1st 24 hrs. Nat.

1st 24 hrs. after shot

Gas Cu. Ft.

Dry Hole

Abandoned

Date

NOV 30 1938 19

H. D. Hatfield Scout

Map No. 11 Sec. 36 Twp. 30 R. 6E

Well No. 1 Snodgrass

Barnsdall Company

Contractor

ABANDONED

NW SE

330 Ft. from N. Line

_____ Ft. from S. Line

_____ Ft. from E. Line

330 Ft. from W. Line

WILDCAT

SECTION PLAT

		0	

Location _____

Rig up _____

Drilling and Remarks:

S.O. 2900-06
2916-20

1/4 Bw 2965-70

DYA

RECORD

Cased 6 in., 2889 ft.

Sand MISS 2900

Gas _____

Oil _____

Total Depth 3000

PRODUCTION

1st ~~24~~ hrs. Nat. _____

1st 24 hrs. after shot _____

Gas _____ Cu. Ft.

Dry Hole _____

Abandoned _____

Date

FEB 8 1939

H.D.H.

Scout

By Paul